

MISSISSIPPI DEPARTMENT OF NATURAL RESOURCES

Bureau of Land and Water Resources

Southport Mall

P.O. Box 10631

Jackson, Mississippi 39209

WATER WELL DRILLERS LOG

<u>Harrison</u>
<u>J</u>
<u>7089</u>

June 9 1983

Duncan Well Drilling Harrison

date well completed

firm name

county well located

LANDOWNER: Ternon Adnor
Rt. 3 Box 310
Pass Christian, Ms.
 (mailing address)

description of formations encountered

from

to

<u>Sand</u>	<u>0</u>	<u>90</u>
<u>clay</u>	<u>90</u>	<u>110</u>
<u>Clay + Sand</u>	<u>110</u>	<u>120</u>
<u>Blue Clay</u>	<u>120</u>	<u>147</u>
<u>Clay + Sand</u>	<u>147</u>	<u>180</u>
<u>Yemas Sand</u>	<u>180</u>	<u>190</u>
<u>Hard Sand</u>	<u>190</u>	<u>220</u>

WELL LOCATION:

sec. 26 T. 7 N. R. 13 E. S. 1 W.
8 miles N.E. of Delisle
 (distance) (direction) (nearest town)

WELL PURPOSE: Home
 (home, irrigation, municipal, industrial)

WELL COMPLETION DATA:

- (1) diameter (inches) 2"
- (2) total depth (feet) 220 ft.
- (3) static water level (feet) 0 below above top of ground.
- (4) casing PVC, 210'
 (material) (depth)
- (size) if telescope see back.
- (5) screen 10', 210'
 (length) (depth to top)
- 2", PVC
 (size) (material)
- (6) pump (HP) (yield gpm)
- (type power)
- (7) electric log (yes or no)
- (organization running log)
- (8) how well bottom plugged

DEPT. OF NATURAL RESOURCES
 BUREAU OF LAND & WATER RESOURCES


AUG 15 1983

RECEIVED

DRILLERS REMARKS: Owner had his own pump

If well telescopes please sketch and show depths.

GROUND LEVEL

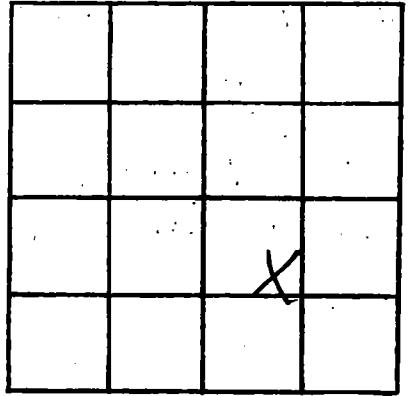

SECTION 26

Please indicate well location X.

ADDITIONAL INFORMATION

If more than one screen, show locations of each on sketch.