

MISSISSIPPI DEPARTMENT OF NATURAL RESOURCES

Bureau of Land and Water Resources

Southport Mall

P.O. Box 10631

Jackson, Mississippi 39209

WATER WELL DRILLERS LOG

Harrison
J
2091

3/16 1984 Braden Pump & Well Harrison  
 date well completed firm name county well located

LANDOWNER: <u>Charles Brown</u>	description of formations encountered	from	to
<u>Recan Rd</u> <u>Pass Christian MS</u> (mailing address)			
WELL LOCATION: sec <u>35</u> T <u>7</u> R <u>13</u> S W	<u>Sand &amp; Clay</u>	<u>0</u>	<u>200</u>
<u>6</u> miles <u>North</u> of <u>Pass Christian</u> (distance) (direction) (nearest town)	<u>Clay</u>	<u>200</u>	<u>300</u>
WELL PURPOSE: <u>Home</u> (home, irrigation, municipal, industrial)	<u>Sand</u>	<u>300</u>	<u>320</u>
WELL COMPLETION DATA: (1) diameter (inches) <u>2"</u>	<u>Blue Clay</u>	<u>320</u>	<u>500</u>
(2) total depth (feet) <u>580</u>	<u>Sand</u>	<u>500</u>	<u>580</u>
(3) static water level (feet) <u>31</u> below top of ground.			
(4) casing <u>PVC</u> <u>550</u> (material) (depth)			
<u>2"</u> (size) if telescope see back.			
(5) screen <u>10 FT</u> <u>550</u> (length) (depth to top)			
<u>2"</u> <u>PVC</u> <u>1008 5/8"</u> (size) (material)			
(6) pump <u>1</u> <u>10</u> (HP) (yield gpm)			
<u>230V</u> (type power)			
(7) electric log <u>NO</u> (yes or no)			
(organization running log)			
(8) how well bottom plugged <u>2" Sand Shank</u>			
DRILLERS REMARKS: <u>20' tailpipe</u>			


DEPT. OF NATURAL RESOURCES  
 BUREAU OF LAND & WATER RESOURCES

APR 13 1984

RECEIVED

If well telescopes please sketch and show depths.

GROUND LEVEL

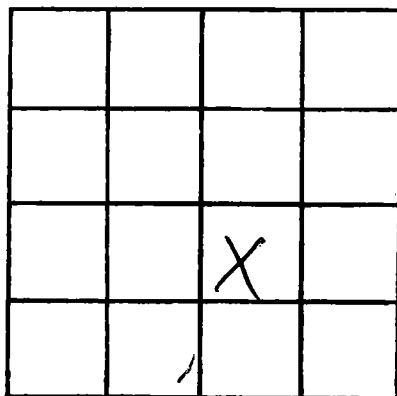

SECTION 36

Please indicate well location X.

ADDITIONAL INFORMATION

If more than one screen,  
show locations of each on sketch.