

MISSISSIPPI DEPARTMENT OF NATURAL RESOURCES

Bureau of Land and Water Resources

Southport Mall

P.O. Box 10631

Jackson, Mississippi 39209

WATER WELL DRILLERS LOG

Harrison
8
2099

7/16/84 Braden Pump & Well Drilling Harrison
date well completed firm name county well located

LANDOWNER: Robert Cook
Pt. 3, Box 204
Pass Christian, Ms.
39571 (mailing address)

description of formations encountered

from to

red clay	0	20
sand	20	80
blue clay	80	340
fine sand	340	380
blue clay	380	460
grey sand	460	520

WELL LOCATION:
sec 39 T 7 S R 13 W
1 miles N of Delisle
(distance) (direction) (nearest town)

WELL PURPOSE: Home
(home, irrigation, municipal, industrial)

- WELL COMPLETION DATA:
- (1) diameter (inches) 2"
 - (2) total depth (feet) 520
 - (3) static water level (feet) 23 below top of ground
 - (4) casing PVC 500' (material) (depth)
 - 2" (size) if telescope see back.
 - (5) screen 10' 500' (length) (depth to top)
 - 2" PVC (size) (material)
 - (6) pump 1 (HP) 10 (yield gpm)
 - 230 V (type power)
 - (7) electric log no (yes or no)

DEPT. OF NATURAL RESOURCES
BUREAU OF LAND & WATER RESOURCES


AUG 26 1984
RECEIVED

(organization running log)
(8) how well bottom plugged PVC
sand shark

DRILLERS REMARKS: 10' tail pipe

If well telescopes please sketch and show depths.

GROUND LEVEL

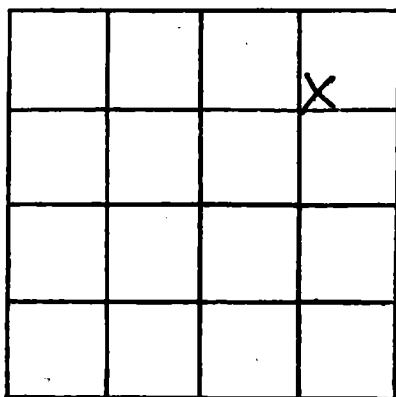

SECTION 39

Please indicate well location X.

ADDITIONAL INFORMATION

If more than one screen,
show locations of each on sketch.