

MISSISSIPPI DEPARTMENT OF NATURAL RESOURCES

Bureau of Land and Water Resources

Southport Mall

P.O. Box 10631

Jackson, Mississippi 39209

WATER WELL DRILLERS LOG

HARRISON  
J 2107

5/22/85 19  
date well completed

Lyman Well Co.  
firm name

Harrison  
county well located

LANDOWNER: Victor Grone

202 Woodland Way

Pass Christian, Md

(mailing address) 39571

description of formations encountered

Red clay

Blue clay

cone sand

from

to

0 40

40 300

300 323

WELL LOCATION:

sec. 9 T 7 N R 13 E  
10 miles north of Belisle  
(distance) (direction) (nearest town)

WELL PURPOSE: House use  
(home, irrigation, municipal, industrial)

WELL COMPLETION DATA:

(1) diameter (inches) 2"  
(2) total depth (feet) 333'  
(3) static water level (feet) 62' below top of ground.

(4) casing PVC 323'  
(material) (depth)

2" (size) If telescope see back.

(5) screen 10' 323'  
(length) (depth to top)

2" PVC (size) (material)

(6) pump N/A (HP) (yield gpm)

(type power)

(7) electric log No (yes or no)

No (organization running log)

(8) how well bottom plugged Sand Shark


DRILLERS REMARKS:

RECEIVED  
AUG 20 1985

Department of Natural Resources  
Bureau of Land & Water Resources

If well telescopes please sketch and show depths.

GROUND LEVEL

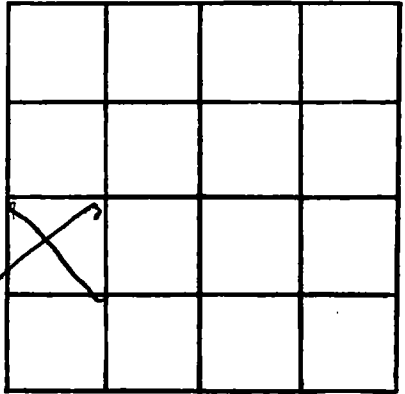

SECTION 9

Please indicate well location X.

ADDITIONAL INFORMATION

If more than one screen, show locations of each on sketch.