

MISSISSIPPI DEPARTMENT OF NATURAL RESOURCES

Bureau of Land and Water Resources

Southport Mall

P.O. Box 10631

Jackson, Mississippi 39209

WATER WELL DRILLERS LOG

**HARRISON**  
**J 2108**

6-14 1985 Mc Hill Pump Wells Harrison  
 date well completed firm name county well located

LANDOWNER: James Ellis  
P.O. Box 612  
Kilmer Mo. 39556  
 (mailing address)

WELL LOCATION:  
 sec. 18 T 9 N R. 13 E  
 (S) (W)  
10 miles NW of Delisle  
 (distance) (direction) (nearest town)

WELL PURPOSE:  
 (home, irrigation, municipal, industrial)

WELL COMPLETION DATA:

- (1) diameter (inches) 2"
- (2) total depth (feet) 400'
- (3) static water level (feet) 40' (below/above top of ground)
- (4) casing Pvc 4" 390'  
 (material) (depth)

(size) if telescope see back.

- (5) screen 10' 390'  
 (length) (depth to top)  
2" Sch. 80 6 slot  
 (size) (material)

- (6) pump N/A   
 (HP) (yield gpm)  
N/A  
 (type power)

- (7) electric log   
 (yes or no)

(organization running log)

- (8) how well bottom plugged SAND  
SHARK

DRILLERS REMARKS:


description of formations encountered	from	to
Mud/Sand	0	20
Mud	20	40
Sand	40	60
Sand/Mud	60	80
Mud	80	120
Mud/Sand	120	140
Mud	140	320
Mud/Sand	320	340
Sand	340	400

**RECEIVED**  
**JUL 8 - 1985**

Department of Natural Resources  
 Bureau of Land & Water Resources

If well telescopes please sketch and show depths.

GROUND LEVEL

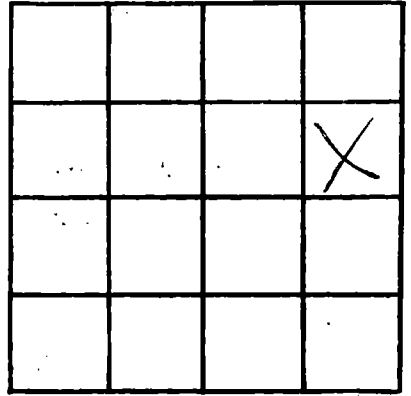

SECTION \_\_\_\_\_

Please indicate well location X.

ADDITIONAL INFORMATION

If more than one screen,  
show locations of each on sketch.