

MISSISSIPPI DEPARTMENT OF NATURAL RESOURCES

Bureau of Land and Water Resources

Southport Mall

P.O. Box 10631

Jackson, Mississippi 39209

WATER WELL DRILLERS LOG

HARRISON
J 209

7-12-

date well completed

1985 McMill Pump Well

firm name

Harrison

county well located

LANDOWNER: Vincent Campbell

description of formations encountered

from

to

Rt. 2 Box 169

Pass Christian Mo. 39571

(mailing address)

WELL LOCATION:

sec. 14 T 7 N R 18 E
5 miles NE of Delisle
(distance) (direction) (nearest town)

WELL PURPOSE:

(home, irrigation, municipal, industrial)

WELL COMPLETION DATA:

- (1) diameter (inches) 2"
- (2) total depth (feet) 430'
- (3) static water level (feet) 80' (below) above top of ground.
- (4) casing 4" Sch. 40 PVC, 420' (material) (depth)
- (size) if telescope see back.
- (5) screen 10' 420' (length) (depth to top)
- 2" Sch. 80 galv PVC (size) (material)
- (6) pump 1 7 (HP) (yield gpm)
- Elec. (type power)
- (7) electric log (yes or no)
- (organization running log)

(8) how well bottom plugged SAND SHARK

Mud	0	20
Mud/Sand	20	40
Sand	40	60
Sand/Gravel	60	160
Sand/Mud	160	180
Mud	180	220
Mud/Sand	220	240
Sand/Mud	240	260
Mud/Sand	260	280
Mud/Sand	280	300
Mud	300	360
Mud/Sand	360	380
Sand	380	430


RECEIVED
AUG 20 1985

DRILLERS REMARKS:

Department of Natural Resources
Bureau of Land & Water Resources

If well telescopes please sketch and show depths.

GROUND LEVEL

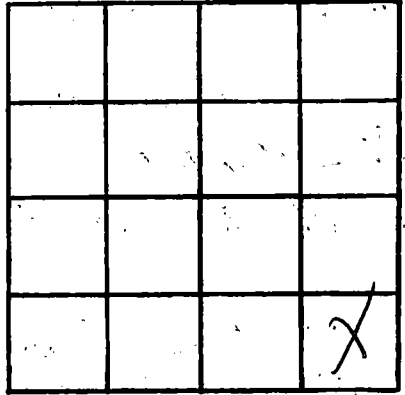

SECTION _____

Please indicate well location X.

ADDITIONAL INFORMATION

If more than one screen, show locations of each on sketch.