

**MISSISSIPPI DEPARTMENT OF NATURAL RESOURCES**  
**Bureau of Land and Water Resources**  
 Southport Mall  
 P.O. Box 10631  
 Jackson, Mississippi 39209  
**WATER WELL DRILLERS LOG**

J 2111  
Horriox  
8-23-85

8-23 1985 McMill Pump Well Horriox  
 date well completed firm name county well located

LANDOWNER: Kimberly Reynolds  
P.O. - Box 391  
Pass Christian Ms. 39571  
 (mailing address)

WELL LOCATION:  
 sec. 6 T. 7 N. R. 13 E  
4 miles S of Deaderud  
 (distance) (direction) (nearest town)

WELL PURPOSE:  
 (home, irrigation, municipal, industrial)

WELL COMPLETION DATA:  
 (1) diameter (inches) 2"  
 (2) total depth (feet) 285'  
 (3) static water level (feet) \_\_\_\_\_ below  
 top of ground. above  
 (4) casing Sch. 40 Pvc. 275'  
 (material) (depth)  
 \_\_\_\_\_ If telescope see back.  
 (size)  
 (5) screen 10' 275'  
 (length) (depth to top)  
2" Sch 80 Pvc - 6 slot  
 (size) (material)  
 (6) pump 1 8  
 (HP) (yield gpm)  
Elec  
 (type power)  
 (7) electric log \_\_\_\_\_  
 (yes or no)  
 \_\_\_\_\_  
 (organization running log)  
 (8) how well bottom plugged Sand  
Shank

description of formations encountered	from	to
<u>Mud</u>	<u>0</u>	<u>40</u>
<u>Mud/Sand</u>	<u>40</u>	<u>60</u>
<u>Mud</u>	<u>60</u>	<u>100</u>
<u>Sand/mud</u>	<u>100</u>	<u>120</u>
<u>Mud/Sand</u>	<u>120</u>	<u>140</u>
<u>Sand/mud</u>	<u>140</u>	<u>160</u>
<u>Mud</u>	<u>160</u>	<u>240</u>
<u>Mud/Sand</u>	<u>240</u>	<u>280</u>
<u>Sand</u>	<u>280</u>	<u>285</u>


**RECEIVED**  
 OCT - 8 1985

Department of Natural Resources  
 Bureau of Land & Water Resources

DRILLERS REMARKS:

If well telescopes please sketch and show depths.

GROUND LEVEL

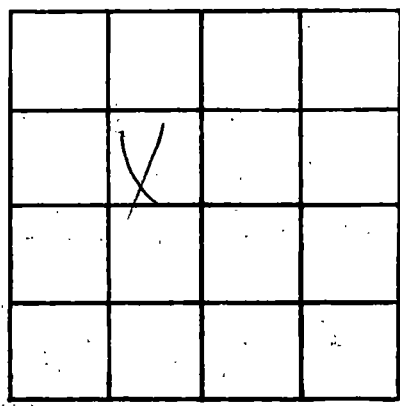

SECTION \_\_\_\_\_

Please indicate well location X.

**ADDITIONAL INFORMATION**

A series of horizontal lines for writing additional information, consisting of 20 lines.

If more than one screen, show locations of each on sketch.