

MISSISSIPPI DEPARTMENT OF NATURAL RESOURCES
Bureau of Land and Water Resources
 Southport Mall
 P.O. Box 10631
 Jackson, Mississippi 39209
WATER WELL DRILLERS LOG

J 2112
 Harrison
 8-21-85

8-21 1985 Mc Hill Pump & Well Harrison
 date well completed firm name county well located

LANDOWNER: Billy Fennell
P.O. Box 33 Long Beach
Ms. 39560
 (mailing address)

WELL LOCATION:
 sec. 10 T. 7 N R. 13 E
3 miles N of I-10
 (distance) (direction) (nearest town)

WELL PURPOSE:
 (home, irrigation, municipal, industrial)

WELL COMPLETION DATA: 4" = 200'
 2" = 300'

(1) diameter (inches) 4x2

(2) total depth (feet) 500'

(3) static water level (feet) 105' below top of ground. above

(4) casing Sch. 40 PVC 480'
 (material) (depth)
 (size) if telescope see back.

(5) screen 10' 480'
 (length) (depth to top)
2" Sch. 80 - 6 slot
 (size) (material)

(6) pump 1 18
 (HP) (yield gpm)
ELEC.
 (type power)

(7) electric log No
 (yes or no)
 (organization running log)

(8) how well bottom plugged SAND
SEAL

description of formations encountered	from	to
<u>Mud / Sand</u>	<u>0</u>	<u>40</u>
<u>Mud</u>	<u>40</u>	<u>210</u>
<u>Mud / Sand</u>	<u>210</u>	<u>240</u>
<u>Mud</u>	<u>240</u>	<u>370</u>
<u>Mud / Sand</u>	<u>370</u>	<u>400</u>
<u>Mud</u>	<u>400</u>	<u>450</u>
<u>Sand</u>	<u>450</u>	<u>500</u>


RECEIVED
 OCT - 8 1985

Department of Natural Resources
 Bureau of Land & Water Resources

DRILLERS REMARKS:

If well telescopes please sketch and show depths.

GROUND LEVEL

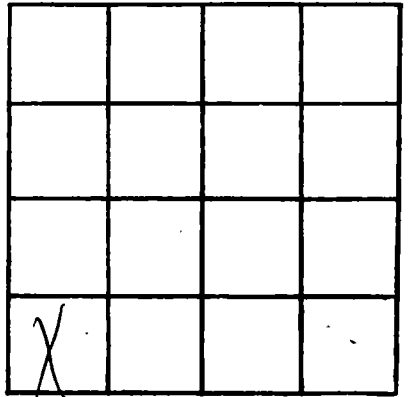

SECTION _____

Please indicate well location X.

ADDITIONAL INFORMATION

If more than one screen,
show locations of each on sketch.