

MISSISSIPPI DEPARTMENT OF NATURAL RESOURCES
Bureau of Land and Water Resources
 Southport Mall
 P.O. Box 10631
 Jackson, Mississippi 39209
WATER WELL DRILLERS LOG

J 2114
Harrison
9-11-85

9-11-85 1985 Metal Pump & Well Harrison
 date well completed firm name county well located

LANDOWNER: Cecil Ladner

Pl. 2 Box 950

Pass Christian Ms.
 (mailing address)

WELL LOCATION:

sec. 10 T. 7 N. R. 13 E.
4 miles North of Delisle
 (distance) (direction) (nearest town)

WELL PURPOSE:
 (home, irrigation, municipal, industrial)

WELL COMPLETION DATA:

- (1) diameter (inches) 2"
 (2) total depth (feet) 520'
 (3) static water level (feet) 50' below above
 top of ground.
 (4) casing Sch 40 PVC, 510'
 (material) (depth)

 If telescope see back.
 (size)

- (5) screen 10' 510'
 (length) (depth to top)
2" Sch 80 PVC - 6 slot
 (size) (material)

- (6) pump N/A
 (HP) (yield gpm)

 (type power)

- (7) electric log
 (yes or no)

 (organization running log)

- (8) how well bottom plugged Sand
Slack

DRILLERS REMARKS:


description of formations encountered	from to	
	ft	ft
<u>Mud</u>	<u>0</u>	<u>60</u>
<u>Mud/sand</u>	<u>60</u>	<u>100</u>
<u>Sand</u>	<u>100</u>	<u>150</u>
<u>Mud</u>	<u>150</u>	<u>290</u>
<u>Sand</u>	<u>290</u>	<u>300</u>
<u>Mud</u>	<u>300</u>	<u>340</u>
<u>Sand</u>	<u>340</u>	<u>360</u>
<u>Mud</u>	<u>360</u>	<u>470</u>
<u>Sand</u>	<u>470</u>	<u>520</u>

RECEIVED
 OCT - 8 1985

Department of Natural Resources
 Bureau of Land & Water Resources

If well telescopes please sketch and show depths.

GROUND LEVEL

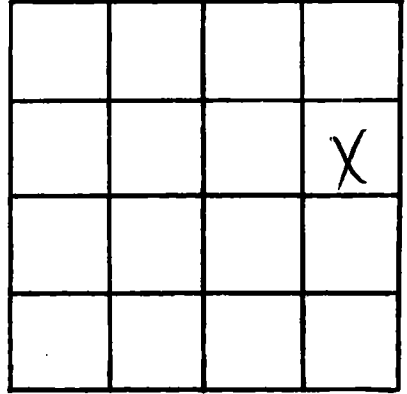

SECTION _____

Please indicate well location X.

ADDITIONAL INFORMATION

If more than one screen, show locations of each on sketch.