

MISSISSIPPI DEPARTMENT OF NATURAL RESOURCES
Bureau of Land and Water Resources
 Southport Mall
 P.O. Box 10631
 Jackson, Mississippi 39209
WATER WELL DRILLERS LOG

HARRISON
52116

10-15-85
 date well completed

R. J. Moore well drill
 firm name

HARRISON
 county well located

LANDOWNER: GARY HAMPTON

description of formations encountered

from to

ROYAL PINES APT 10

ROYAL OAK DRIVE
DRESS CHRISTMAS MS.
 (mailing address)

<u>TOP SdL</u>	<u>0</u>	<u>20</u>
<u>Core white sand & gravel</u>	<u>30</u>	<u>60</u>
<u>Blue clay</u>	<u>60</u>	<u>280</u>
<u>Core & Grey Sand</u>	<u>280</u>	<u>320</u>

WELL LOCATION:

sec. 2 T. 2 N. R. 13 E. S. 5 W. 6 miles N of PROGRESS MS.
 (distance) (direction) (nearest town)

WELL PURPOSE:

(home irrigation, municipal, industrial)

WELL COMPLETION DATA:

- diameter (Inches) 2"
- total depth (feet) 320'
- static water level (feet) 30' below top of ground.
- casing PVC, 320'
 (material) (depth)
2" if telescope see back.
 (size)
- screen 2'x10', 320'
 (length) (depth to top)
PVC
 (size) (material)
- pump 1 8
 (HP) (yield gpm)
E
 (type power)
- electric log _____
 (yes or no)

(organization running log)

(8) how well bottom plugged BW
blue

RECEIVED


JAN 09 1986

Department of Natural Resources
 Bureau of Land & Water Resources

DRILLERS REMARKS:

If well telescopes please sketch and show depths.

GROUND LEVEL

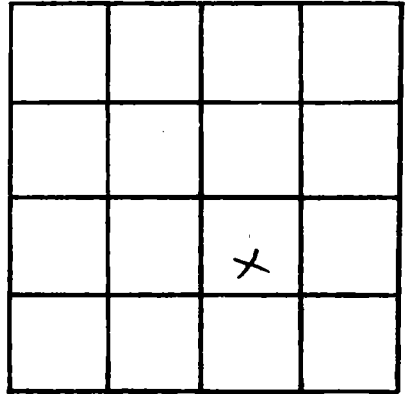

SECTION 2

Please indicate well location X.

ADDITIONAL INFORMATION

If more than one screen,
show locations of each on sketch.