

MISSISSIPPI DEPARTMENT OF NATURAL RESOURCES

Bureau of Land and Water Resources

Southport Mall

P.O. Box 10631

Jackson, Mississippi 39209

WATER WELL DRILLERS LOG

HARRISON
J
2120

May 29 1986  
date well completed

McGee  
firm name

Harrison  
county well located

LANDOWNER:	description of formations encountered	from	to
Margaret Ladner 1000 North Island View Long Beach Mo. 39560 (mailing address)	Sand mud Sand	0 15 260	15 260 300
<b>WELL LOCATION:</b>			
sec. 17 T 2 N R 13 E			
2 miles South of Eads Rd (distance) (direction) (nearest town)			
<b>WELL PURPOSE:</b> Home (home, irrigation, municipal, industrial)			
<b>WELL COMPLETION DATA:</b>			
(1) diameter (inches) 2"			
(2) total depth (feet) 300'			
(3) static water level (feet) 40 <sup>below</sup> <sub>above</sub> top of ground.			
(4) casing PVC, 280' (material) (depth) 2" (size) if telescope see back.			
(5) screen 10, Bottom (length) (depth to top) 2" PVC (size) (material)			
(6) pump 1 (HP) 11 (yield gpm) Electric - (220) (type power)			
(7) electric log NO (yes or no)			
(organization running log)			
(8) how well bottom plugged Seal			
<b>DRILLERS REMARKS:</b>			


RECEIVED

AUG 7 1986

Department of Natural Resources  
Bureau of Land & Water Resources

If well telescopes please sketch and show depths.

GROUND LEVEL

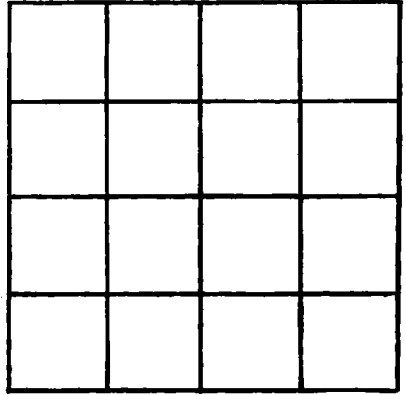

SECTION \_\_\_\_\_

Please indicate well location X.

ADDITIONAL INFORMATION

**RECEIVED**

AUG 7 1986

Department of Natural Resources  
Bureau of Land & Water Resources

If more than one screen, show locations of each on sketch.