

MISSISSIPPI DEPARTMENT OF NATURAL RESOURCES

Bureau of Land and Water Resources

Southport Mall

P.O. Box 10631

Jackson, Mississippi 39209

WATER WELL DRILLERS LOG

HARRISON
J
2123

June 3-1986 19 McMill Pump & Wells Harrison  
 date well completed firm name county well located

LANDOWNER: David Deasa  
Haye Rd  
Long Beach Ms.  
 (mailing address)

WELL LOCATION:  
 sec. 27 T. 2 N. R. 13 E.  
5 miles North of Long Beach  
 (distance) (direction) (nearest town)

WELL PURPOSE: home  
 (home, irrigation, municipal, industrial)

WELL COMPLETION DATA:

(1) diameter (inches) 2"

(2) total depth (feet) 500'

(3) static water level (feet) 50' <sup>(below)</sup> <sub>(above)</sub> top of ground.

(4) casing PVC, 480',  
 (material) (depth)  
2"  
 (size) if telescope see back.

(5) screen 10', Bottom  
 (length) (depth to top)  
2", PVC  
 (size) (material)


(6) pump 1 (HP) 8 (yield gpm)  
electric  
 (type power)

(7) electric log no  
 (yes or no)

(organization running log)

(8) how well bottom plugged Seal

description of formations encountered	from	to
<del>Mud</del>	<del>0</del>	<del>50</del>
<del>Sand</del>	<del>50</del>	<del>100</del>
Mud	0	10
Sand	10	60
Mud	60	180
Sand	180	200
Mud	200	440
Sand	440	500

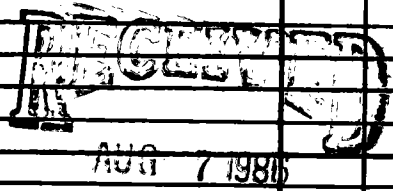


Department of Natural Resources  
 Bureau of Land & Water Resources

DRILLERS REMARKS:

If well telescopes please sketch and show depths.

GROUND LEVEL

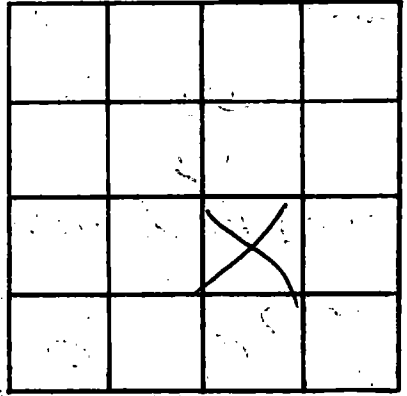

SECTION \_\_\_\_\_

Please indicate well location X.

ADDITIONAL INFORMATION

If more than one screen, show locations of each on sketch.