

MISSISSIPPI DEPARTMENT OF NATURAL RESOURCES

Bureau of Land and Water Resources

Southport Mall

P.O. Box 10631

Jackson, Mississippi 39209

WATER WELL DRILLERS LOG

Harrison
J
2124

July 15-86 19 McMill Pump Wells Harrison
date well completed firm name county well located

LANDOWNER: Bobby Bailey
Rt. 2, Box 903
Pass Christian, Ms.
(mailing address)

description of formations encountered	from	to
<u>Mud</u>	<u>0</u>	<u>130</u>
<u>Sand</u>	<u>130</u>	<u>140</u>
<u>Mud</u>	<u>140</u>	<u>310</u>
<u>Sand</u>	<u>310</u>	<u>340</u>
<u>Mud</u>	<u>340</u>	<u>430</u>
<u>Sand</u>	<u>430</u>	<u>480</u>

WELL LOCATION:
sec. 9 T. 7 N. R. 13 E
4 miles North of Delink
(distance) (direction) (nearest town)

WELL PURPOSE: Home
(home, irrigation, municipal, industrial)

- WELL COMPLETION DATA:
- (1) diameter (inches) 4" x 2"
 - (2) total depth (feet) 480
 - (3) static water level (feet) 90 ^(below) above top of ground.
 - (4) casing PVC, 460'
(material) (depth)
4 1/2"
(size) if telescope see back.
 - (5) screen 20', Bottom
(length) (depth to top)
2", PVC
(size) (material)
 - (6) pump 1 sub, 17
(HP) (yield gpm)
Electric
(type power)
 - (7) electric log No
(yes or no)
(organization running log)
 - (8) how well bottom plugged Seal

DRILLERS REMARKS:

RECEIVED
AUG 26 1986

Department of Natural Resources
Bureau of Land & Water Resources


If well telescopes please sketch and show depths.

GROUND LEVEL

200'-4" Top

260'-2" Bottom

20' Screen

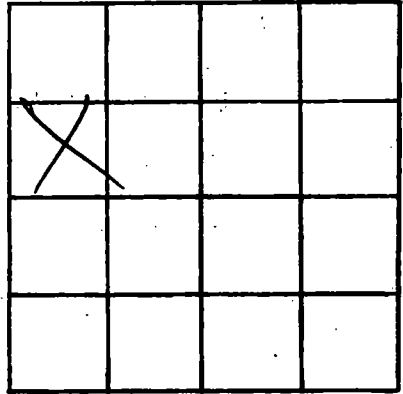

SECTION _____

Please indicate well location X.

ADDITIONAL INFORMATION

If more than one screen, show locations of each on sketch.