

MISSISSIPPI DEPARTMENT OF NATURAL RESOURCES

Bureau of Land and Water Resources

Southport Mall

P.O. Box 10631

Jackson, Mississippi 39209

WATER WELL DRILLERS LOG

Harrison
J
2125

July 24 1986 McMill Pump & Well Harrison
date well completed firm name county well located

LANDOWNER Donald Edelen
Rt. 3, Box 677-A
Pass Christian, Mo.
(mailing address)

description of formations encountered	from	to
<u>Mud</u>	<u>0</u>	<u>10</u>
<u>Sand</u>	<u>10</u>	<u>90</u>
<u>Sand/Gravel</u>	<u>90</u>	<u>120</u>
<u>Mud</u>	<u>120</u>	<u>500</u>
<u>Sand</u>	<u>500</u>	<u>560</u>

WELL LOCATION:
sec. 33 T. 7 N. R. 13 E.
1 miles North of Delisle
(distance) (direction) (nearest town)

WELL PURPOSE: Home
(home, irrigation, municipal, industrial)

- WELL COMPLETION DATA:
- (1) diameter (inches) 4" x 2"
 - (2) total depth (feet) 550 ~~560~~
 - (3) static water level (feet) 40' ^(below) above top of ground
 - (4) casing PVC, 530' ^(depth)
 - 4" x 2" If telescope see back.
(size)
 - (5) screen 20', Bottom
(length) (depth to top)
 - 2", PVC
(size) (material)
 - (6) pump 1 sub, 18
(HP) (yield gpm)
 - Electric
(type power)
 - (7) electric log NO
(yes or no)

(organization running log)
(8) how well bottom plugged Seal

DRILLERS REMARKS:

RECEIVED

AUG 26 1986

Department of Natural Resources
Bureau of Land & Water Resources

If well telescopes please sketch and show depths.


GROUND LEVEL

180' 4" Top

380' 2" Bottom

~~30'~~

20' Screen

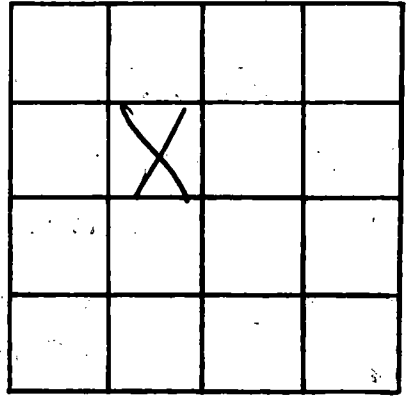

SECTION _____

Please indicate well location X.

ADDITIONAL INFORMATION

Lined area for additional information.

If more than one screen, show locations of each on sketch.