

MISSISSIPPI DEPARTMENT OF NATURAL RESOURCES
 Bureau of Land and Water Resources
 Southport Mall
 P.O. Box 10631
 Jackson, Mississippi 39209
WATER WELL DRILLERS LOG

Harrison
J
2126

2/23/86 19 Lipman Well Co Harrison
 date well completed firm name county well located

LANDOWNER: Glen Laugh

| description of formations encountered | from | to |
|---------------------------------------|-------------|-------------|
| <u>Topsoil</u> | | <u>5'</u> |
| <u>Clay</u> | <u>1'</u> | <u>11'</u> |
| <u>Sand</u> | <u>11'</u> | <u>132'</u> |
| <u>Clay</u> | <u>132'</u> | <u>280'</u> |
| <u>Sand</u> | <u>280'</u> | <u>284'</u> |
| <u>Clay</u> | <u>284'</u> | <u>301'</u> |
| <u>Gravel</u> | <u>301'</u> | <u>307'</u> |
| <u>Clay</u> | <u>307'</u> | <u>381'</u> |
| <u>Sand</u> | <u>381'</u> | <u>406'</u> |

(mailing address)

WELL LOCATION:

sec. 14 T. 7 N. R. 13 E.
8 miles (S) N of Pass C.
 (distance) (direction) (nearest town)

WELL PURPOSE: Home
 (home, irrigation, municipal, industrial)

WELL COMPLETION DATA:

- (1) diameter (inches) 2"
- (2) total depth (feet) 406'
- (3) static water level (feet) 95' below above top of ground.
- (4) casing PVC, 396'
 (material) (depth)
2"
 (size) if telescope see back.
- (5) screen 10', 396'
 (length) (depth to top)
2" PVC
 (size) (material)
- (6) pump 1 1/2 7
 (HP) (yield gpm)
electric
 (type power)
- (7) electric log No
 (yes or no)
No
 (organization running log)
- (8) how well bottom plugged sand
shark


RECEIVED
 OCT 14 1986

Department of Natural Resources
 Bureau of Land & Water Resources

DRILLERS REMARKS:

If well telescopes please sketch and show depths.

GROUND LEVEL

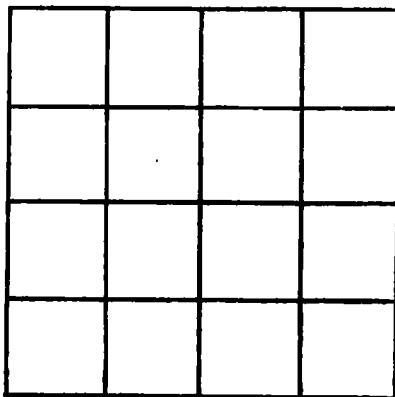

SECTION _____

Please indicate well location X.

ADDITIONAL INFORMATION

If more than one screen, show locations of each on sketch.