

MISSISSIPPI DEPARTMENT OF NATURAL RESOURCES

Bureau of Land and Water Resources

Southport Mall

P.O. Box 10631

Jackson, Mississippi 39209

WATER WELL DRILLERS LOG

HARRISON
J
2127

Aug. 14 1986 Ward Well Drg Harrison
 date well completed firm name county well located

LANDOWNER: G.H. & J. Seligson
 Menge Ave.
 Pass Christian, Ms.
 (mailing address)

description of formations encountered	from	to
	Top Soil - Clay	0
Clay - clay	18	24
clay	24	95
clay - clay	95	210
clay - silt	210	385
coarse sd	385	420

WELL LOCATION:
 sec. 24 T 7 N R 13 E
 10 miles N of P.C.
 (distance) (direction) (nearest town)

WELL PURPOSE: Industrial
 (home, irrigation, municipal, industrial)

WELL COMPLETION DATA:

(1) diameter (inches) 2"

(2) total depth (feet) 420'

(3) static water level (feet) 98' below above top of ground.

(4) casing PVC 410'
 (material) (depth)

(size) if telescope see back.

(5) screen 10' -
 (length) (depth to top)
 2" PVC
 (size) (material)

(6) pump 1 7
 (HP) (yield gpm)
 Elec.
 (type power)

(7) electric log NO
 (yes or no)
 N/A
 (organization running log)

(8) how well bottom plugged BWU

RECEIVED


OCT 06 1986

Department of Natural Resources
 Bureau of Land & Water Resources

DRILLERS REMARKS: N/A

If well telescopes please sketch and show depths.

GROUND LEVEL

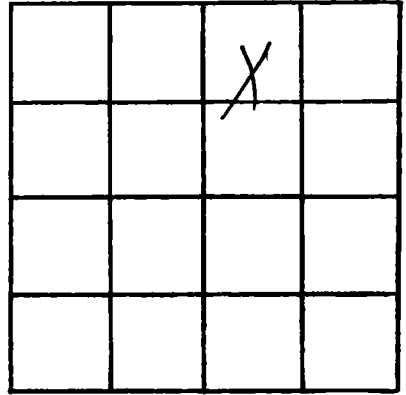

SECTION 24

Please indicate well location X.

ADDITIONAL INFORMATION

If more than one screen, show locations of each on sketch.