

MISSISSIPPI DEPARTMENT OF NATURAL RESOURCES

Bureau of Land and Water Resources

Southport Mall

P.O. Box 10631

Jackson, Mississippi 39209

WATER WELL DRILLERS LOG

Harrison  
J  
2128

July 28 1986 Methyl Pump Well Harrison  
Date well completed firm name county well located

LANDOWNER: Herman McArthur  
P.O. Box 301  
Pass Christian, Ms  
(mailing address)

WELL LOCATION:  
sec 14 T 7 N R 13 E  
8 miles WEST of Gulfport  
(distance) (direction) (nearest town)

WELL PURPOSE: Home  
(home, irrigation, municipal, industrial)

- WELL COMPLETION DATA:
- (1) diameter (inches) 2"
  - (2) total depth (feet) 500'
  - (3) static water level (feet) 60' below top of ground
  - (4) casing PVC, 4" ID, 2" (size) If telescope see back.
  - (5) screen 10' (length) Bottom (depth to top) 2" (size) PVC (material)
  - (6) pump 1 (HP) 9 (yield gpm) Electric (type power)
  - (7) electric log no (yes or no)
  - (8) how well bottom plugged Seal

description of formations encountered	from	to
Mud	0	30
Sand/Gravel	30	120
Mud	120	230
Sand	230	240
Mud	240	340
Sand/Mud	340	420
Mud	420	470
Sand	470	500


DRILLERS REMARKS:

RECEIVED  
AUG 20 1986

Department of Natural Resources  
Bureau of Land & Water Resources

If well telescopes please sketch and show depths.

GROUND LEVEL

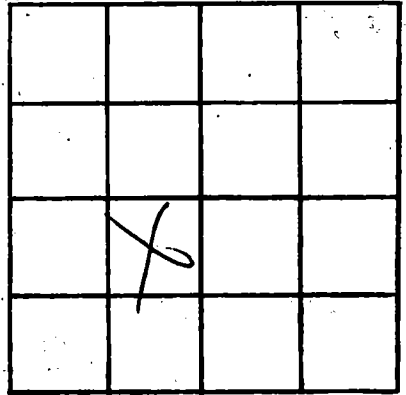

SECTION \_\_\_\_\_

Please indicate well location X.

ADDITIONAL INFORMATION

If more than one screen, show locations of each on sketch.