

MISSISSIPPI DEPARTMENT OF NATURAL RESOURCES

Bureau of Land and Water Resources

P.O. Box 10631

Jackson, Mississippi 39209

WATER WELL DRILLERS LOG

COUNTY WELL LOCATED Harrison	
WELL NUMBER 2	CODED
2129	
DATE WELL COMPLETED Aug 20 1986	

PERMIT NUMBER
NAME OF DRILLING FIRM Mississippi Pump & Wells

NAME & MAILING ADDRESS OF LANDOWNER Robert Williams			
WELL LOCATION:	SEC	TOWNSHIP	RANGE
	16	7 N	12 E
DISTANCE	DIRECTION	NEAREST TOWN	
6 Miles	North	of	
OTHER LANDMARK			
WELL PURPOSE: Home, Irrigation, Municipal, Industrial, Fish Pond, etc. Home			

PUMP DATA		
PUMP TYPE (Circle One): <input checked="" type="radio"/> Submersible Turbine Jet Flowing Well. Other (Describe) _____		
POWER TYPE (Circle One): <input checked="" type="radio"/> Electric Tractor Diesel Gasoline Butane. Other (Describe) _____		
Pump Capacity (GPM) 35	No. of Stages	Setting Depth 60 FT.
PUMP TEST		
Well yielded 25 GPM with a drawdown of 15 ft. after 1 hours of pumping		

WELL DATA		
Well Depth 530'	Casing Diameter (In.) 2" x 4"	Casing Length (Ft.) 510'
Type of Casing PVC	Hole Depth 540'	Depth to Static Water Level 10'
TYPE OF COMPLETION: (Circle One or More): <input checked="" type="checkbox"/> Gravel Packed; <input type="checkbox"/> Underreamed, <input type="checkbox"/> Telescoped, <input checked="" type="checkbox"/> Natural Development, <input type="checkbox"/> Open Hole, <input type="checkbox"/> Other		
Top of Lap Pipe or Reduction in Casing		
FEET	IF TELESCOPED OR MORE THAN ONE SCREEN: USE BACK PAGE	

LOG DATA	
TYPE OF LOG RUN (Circle One): No Log Run, Electric, Gamma Ray, Density, Sonic, Neutron, Other (Describe) _____	
Name of Organization Running Log	

SCREEN DATA		
Diameter - Inches 2"	Length - Feet 20'	Slot Size - Inches 6ths
Screen Type PVC	Depth to Bottom - Feet 530'	

GEOLOGIC DATA (Office Use Only)			
Surface Elev.	Geologic Unit	Unit Thickness	Depth to Top
Subs. SWL	Date	Analysis	Aquifer Test


Driller's Remarks

DESCRIPTION OF FORMATIONS ENCOUNTERED	FROM	TO	FORMATIONS (continued)
Mud	0	20	<div style="font-size: 2em; font-weight: bold; opacity: 0.5; transform: rotate(-5deg); display: inline-block;">RECEIVED</div> <div style="font-size: 1.5em; font-weight: bold;">NOV 3 1986</div> <div style="font-size: 0.8em;">Department of Natural Resources Bureau of Land & Water Resources</div>
Sand	20	40	
Mud	40	210	
Sand	210	250	
Mud	250	420	
Sand	420	430	
Mud	430	460	
Sand	460	530	

IF MORE SPACE IS NEEDED, USE BACK

If well telescopes please sketch and show depths.

GROUND LEVEL

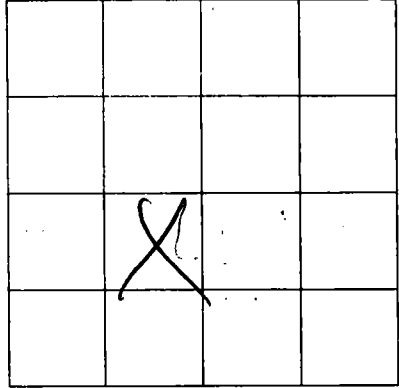

SECTION _____

Please indicate well location X.

ADDITIONAL INFORMATION

If more than one screen, show location of each on sketch.