

MISSISSIPPI DEPARTMENT OF NATURAL RESOURCES
Bureau of Land and Water Resources

P.O. Box 10631

Jackson, Mississippi 39209

WATER WELL DRILLERS LOG

COUNTY WELL LOCATED Harrison	
WELL NUMBER 2130	CODED
DATE WELL COMPLETED Sept. 1-84	

PERMIT NUMBER
NAME OF DRILLING FIRM McNeil Pump & Wells

NAME & MAILING ADDRESS OF LANDOWNER Charles Whittman		
300 Alexander Rd		
Long Beach Ms.		
WELL LOCATION: SEC	TOWNSHIP	RANGE
33	T7	R13 E
DISTANCE	DIRECTION	NEAREST TOWN
8 Miles	North of	Long Beach
OTHER LANDMARK		
WELL PURPOSE: Home, Irrigation, Municipal, Industrial, Fish Pond, etc. Home		

PUMP DATA		
PUMP TYPE (Circle One): Submersible , Turbine, Jet, Flowing Well, Other (Describe)		
POWER TYPE (Circle One): Electric , Tractor, Diesel, Gasoline, Butane, Other (Describe)		
Pump Capacity (GPM) 25	No. of Stages	Setting Depth 60' FT.
PUMP TEST		
Well yielded 35 GPM with a drawdown of 15 ft. after 1 hours of pumping		

WELL DATA		
Well Depth 520'	Casing Diameter (In.) 4" X 2"	Casing Length (Ft.) 500'
Type of Casing PVC	Hole Depth 520'	Depth to Static Water Level 30'
TYPE OF COMPLETION: (Circle One or More): Natural Development , Underreamed, Telescoped, Open Hole, Other		
Top of Lap Pipe or Reduction in Casing 140'-4" 380-2" FEET		
IF TELESCOPED OR MORE THAN ONE SCREEN: USE BACK PAGE		

LOG DATA	
TYPE OF LOG RUN (Circle One): Electric, Gamma Ray, Density, Sonic, Neutron, Other (Describe) No Log Run	
Name of Organization Running Log	

SCREEN DATA		
Diameter - Inches 2"	Length - Feet 20'	Slot Size - Inches 6 Thousandths
Screen Type PVC	Depth to Bottom - Feet 520'	

GEOLOGIC DATA (Office Use Only)			
Surface Elev.	Geologic Unit	Unit Thickness	Depth to Top
Subs. SWL	Date	Analysis	Aquifer Test


Driller's Remarks

DESCRIPTION OF FORMATIONS ENCOUNTERED	FROM	TO
Mud	0	10
Sand	10	50
Mud	50	190
Sand	190	230
Mud	230	470
Sand	470	520

RECEIVED	
NOV 3 1986	
Department of Natural Resources Bureau of Land & Water Resources	
IF MORE SPACE IS NEEDED, USE BACK	

If well telescopes please
sketch and show depths.

GROUND LEVEL

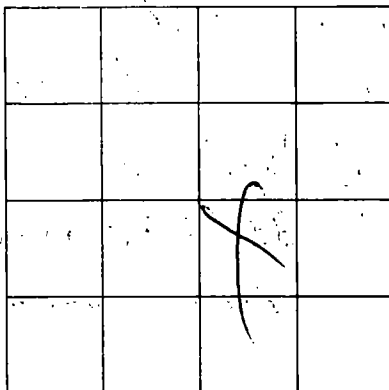

		X	

SECTION _____

Please indicate well location X.

ADDITIONAL INFORMATION

If more than one screen,
show location of each on sketch.