

Harrison
J 2142

MISSISSIPPI
BOARD OF WATER COMMISSIONERS
416 North State Street
Jackson, Mississippi 39201

WATER WELL DRILLERS LOG

4-3-87 19
date well completed

R/Mocho
firm name

Harrison
county well located

LANDOWNER: Jerry Ramos
Menard Ave North

PASS CHRISTIAN MS
(mailing address)

WELL LOCATION:

sec. 24 T 2 N R. 13 E
(S) W
1 miles N of I 10
(distance) (direction) (nearest town)

WELL PURPOSE:

(home, irrigation, municipal, industrial)

WELL COMPLETION DATA:

- (1) diameter (inches) 2"
- (2) total depth (feet) 420'
- (3) static water level (feet) 90 Below top of ground. above
- (4) casing PVC 420
(material) (depth)
 If telescope see back.
(size)
- (5) screen 10' 420
(length) (depth to top)
2" PVC
(size) (material)
- (6) pump 1 1/2 5
(HP) (yield gpm)
E
(type power)
- (7) electric log
(yes or no)

(organization running log)
- (8) how well bottom plugged Bulldoze

description of formations encountered

from to

<u>TOP Soil & red clay</u>	<u>0</u>	<u>20</u>
<u>Red sand & siltstone</u>	<u>20</u>	<u>80</u>
<u>White & red clay</u>	<u>80</u>	<u>160</u>
<u>Blue clay</u>	<u>160</u>	<u>380</u>
<u>Med sand</u>	<u>380</u>	<u>400</u>
<u>Coarse sand</u>	<u>400</u>	<u>420</u>

RECEIVED


APR 03 1987

Department of Natural Resources
Bureau of Land & Water Resources

DRILLERS REMARKS:

If well telescopes please sketch and show depths.

GROUND LEVEL

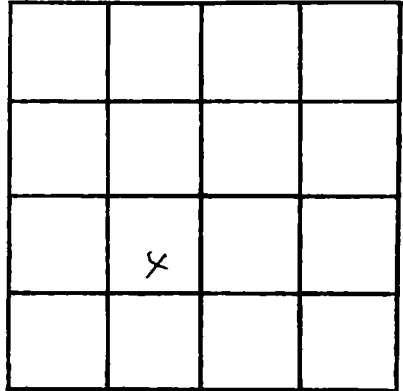

SECTION 24

Please indicate well location X.

ADDITIONAL INFORMATION

A series of 20 horizontal lines for recording additional information.

If more than one screen, show locations of each on sketch.