

County-add-loc-

MISSISSIPPI DEPARTMENT OF NATURAL RESOURCES
Bureau of Land and Water Resources

P.O. Box 10631
Jackson, Mississippi 39209
WATER WELL DRILLERS LOG

COUNTY WELL LOCATED	
Harrison	
WELL NUMBER	CODED
2144	
DATE WELL COMPLETED	
7-24-87	

PERMIT NUMBER
NAME OF DRILLING FIRM
Coastwater Well Svc.

NAME & MAILING ADDRESS OF LANDOWNER		
MJ Saunders		
208 Sedgewick Dr		
Long Beach MS		
WELL LOCATION: SEC	TOWNSHIP	RANGE
34	7 ^N _S	13 ^E _W
DISTANCE	DIRECTION	NEAREST TOWN
5 Miles	N	Pass Christian
OTHER LANDMARK		
WELL PURPOSE: home, Irrigation, Municipal, Industrial, Fish Pond, etc.		
home.		

PUMP DATA		
PUMP TYPE (Circle One):		
Submersible,	Turbine,	Jet Flowing Well,
Other (Describe) _____		
POWER TYPE (Circle One):		
Electric	Tractor,	Diesel, Gasoline, Butane,
Other (Describe) _____		
Pump Capacity (GPM)	No. of Stages	Setting Depth
10	2	_____ FT.
PUMP TEST		
Well yielded _____ GPM with		
a drawdown of _____ ft.		
after _____ hours of pumping		

WELL DATA		
Well Depth	Casing Diameter (In.)	Casing Length (Ft.)
585'	2"	560'
Type of Casing	Hole Depth	Depth to Static Water Level
PVC	585	410'
TYPE OF COMPLETION: (Circle One or More):		
Gravel Packed	Underreamed,	Telescoped,
Natural Development	Open Hole,	Other
(Describe) _____		
Top of Lap Pipe or Reduction in Casing		
FEET	IF TELESCOPED OR MORE THAN ONE SCREEN: USE BACK PAGE	

LOG DATA	
TYPE OF LOG RUN (Circle One):	
Electric, Gamma Ray, Density, Sonic, Neutron,	No Log Run.
Other (Describe) _____	
Name of Organization Running Log	

SCREEN DATA		
Diameter - Inches	Length - Feet	Slot Size - Inches
2"	20'	.008
Screen Type	Depth to Bottom - Feet	
PVC	580	

GEOLOGIC DATA (Office Use Only)			
Surface Elev.	Geologic Unit	Unit Thickness	Depth to Top
Subs. SWL	Date	Analysis	Aquifer Test

Driller's Remarks

RECEIVED

DESCRIPTION OF FORMATIONS ENCOUNTERED	FROM	TO	FORMATIONS (Continued)	FROM	TO
Top Soil	0	2	SEP 21 1987 Department of Natural Resources Bureau of Land & Water Resources		
Red Clay	2	35			
Red Coarse sand	35	102			
Blue Clay	102	170			
Mod Gray Sand	170	190			
Blue Clay	190	215			
Gray Mod Sand	215	280			
Blue Clay	280	531			
Mod Gray Sand	531	580			
Coarse Coarse Sand	580	580			
Blue Clay	580	585			

IF MORE SPACE IS NEEDED, USE BACK

If well telescopes please sketch and show depths.

GROUND LEVEL


		X	

SECTION

34

Please indicate well location X.

ADDITIONAL INFORMATION

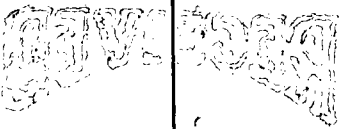

If more than one screen, show location of each on sketch.