

MISSISSIPPI DEPARTMENT OF NATURAL RESOURCES
Bureau of Land and Water Resources

P.O. Box 10631
Jackson, Mississippi 39209
WATER WELL DRILLERS LOG

COUNTY WELL LOCATED <i>Harrison</i>	
WELL NUMBER <i>001</i>	CODED
<i>J 2147</i>	
DATE WELL COMPLETED <i>Sept 3, 1987</i>	

PERMIT NUMBER
NAME OF DRILLING FIRM <i>D+S Well Service</i>
<i>work done under #0471</i>

NAME & MAILING ADDRESS OF LANDOWNER <i>Mr. Billy Slarry</i>			
<i>12328 VIDALIA RD</i>			
<i>able Bridge</i>			
<i>Pass Christian MS 38521</i>			
WELL LOCATION: SEC	TOWNSHIP	RANGE	
<i>3</i>	<i>7 N</i>	<i>13 E</i>	
	<i>S</i>	<i>W</i>	
DISTANCE	DIRECTION	NEAREST TOWN	
<i>7</i> Miles	<i>South</i> of	<i>Pass</i>	
OTHER LANDMARK <i>old able Bridge Lounge</i>			
WELL PURPOSE: <i>Home, Irrigation, Municipal, Industrial, Fish Pond, etc.</i>			

PUMP DATA		
PUMP TYPE (Circle One): Submersible, <u>Turbine</u> , Jet, Flowing Well, Other (Describe) <i>1 hp Morris</i>		
POWER TYPE (Circle One): <u>Electric</u> , Tractor, Diesel, Gasoline, Butane, Other (Describe)		
Pump Capacity (GPM) <i>29</i>	No. of Stages <i>3</i>	Setting Depth <i>60</i> FT.
PUMP TEST		
Well yielded <i>30-29</i> GPM with a drawdown of <i>8'</i> ft. after <i>24 hrs.</i> hours of pumping		

WELL DATA		
Well Depth <i>380</i>	Casing Diameter (In.) <i>2" by 4"</i>	Casing Length (Ft.) <i>380'</i>
Type of Casing <i>Pvc</i>	Hole Depth <i>380'</i>	Depth to Static Water Level <i>60'</i>
TYPE OF COMPLETION: (Circle One or More): Gravel Packed, Underreamed, Telescoped, Natural Development, <u>Open Hole</u> , Other		
Top of Lap Pipe or Reduction in Casing <i>180'</i> FEET		
IF TELESCOPED OR MORE THAN ONE SCREEN: USE BACK PAGE		

LOG DATA	
TYPE OF LOG RUN (Circle One): No Log Run, Electric, Gamma Ray, Density, Sonic, Neutron, Other (Describe)	
Name of Organization Running Log <i>N/A</i>	

SCREEN DATA		
Diameter - Inches <i>2"</i>	Length - Feet <i>20'</i>	Slot Size - Inches <i>6</i>
Screen Type <i>Pvc Slotted</i>	Depth to Bottom - Feet <i>280'</i>	

GEOLOGIC DATA (Office Use Only)			
Surface Elev.	Geologic Unit	Unit Thickness	Depth to Top
Subs. SWL	Date	Analysis	Aquifer Test

Driller's Remarks <i>This well drilled under Parker well service Lic # 0471 Address same</i>


DESCRIPTION OF FORMATIONS ENCOUNTERED	FROM	TO
<i>Surface Sand</i>	<i>0</i>	<i>25</i>
<i>Clay</i>	<i>25</i>	<i>170</i>
<i>Blue clay</i>	<i>170</i>	<i>320</i>
<i>Sand water</i>	<i>320</i>	<i>380</i>

FORMATIONS (Continued)	FROM	TO
RECEIVED		
OCT 07 1987		
Department of Natural Resources Bureau of Land & Water Resources		

IF MORE SPACE IS NEEDED, USE BACK

If well telescopes please sketch and show depths.

GROUND LEVEL

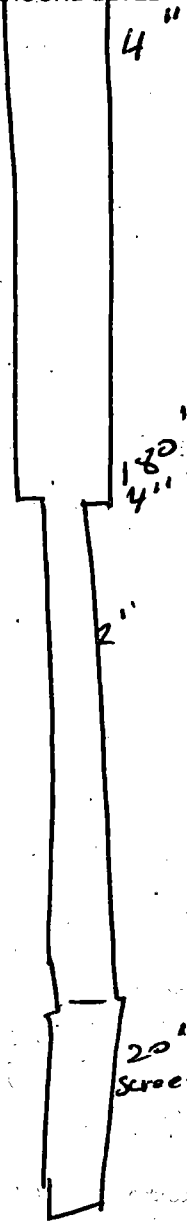

SECTION _____

Please indicate well location X.

ADDITIONAL INFORMATION

A series of horizontal lines provided for additional information, starting below the "ADDITIONAL INFORMATION" header and extending to the bottom of the page.

If more than one screen, show location of each on sketch.