

MISSISSIPPI DEPARTMENT OF NATURAL RESOURCES

Bureau of Land and Water Resources

Southport Mall

P.O. Box 10631

Jackson, Mississippi 39209

WATER WELL DRILLERS LOG

HARRISON
J 2149

R.V. Moore

HARRISON

11-12-87 19
date well completed

firm name

county well located

LANDOWNER: E. C. Williams
PT #2 Box 20131
MEADOT RD

description of formations encountered	from	to
<u>TOP SAND clay</u>	<u>0</u>	<u>20</u>
<u>Red clay</u>	<u>20</u>	<u>60</u>
<u>Red sand & gravel</u>	<u>60</u>	<u>80</u>
<u>White clay</u>	<u>80</u>	<u>160</u>
<u>White sand</u>	<u>160</u>	<u>200</u>
<u>Red clay</u>	<u>200</u>	<u>400</u>
<u>Med sand</u>	<u>400</u>	<u>410</u>
<u>CORSE SAND</u>	<u>410</u>	<u>420</u>

PASS Cherith m/s
(mailing address)

WELL LOCATION:
sec. 25 T 7 N R 13 E
6 miles N of Cherith
(distance) (direction) (nearest town)

WELL PURPOSE:
(home, irrigation, municipal, industrial)

- WELL COMPLETION DATA:
- (1) diameter (inches) 2"
 - (2) total depth (feet) 420'
 - (3) static water level (feet) 100' below above top of ground.
 - (4) casing Pvc, 420',
(material), (depth),
 if telescope see back.
(size)
 - (5) screen 10', 420'
(length), (depth to top)
2", Pvc
(size), (material)
 - (6) pump 1 1/2, 6
(HP), (yield gpm)
E
(type power)
 - (7) electric log
(yes or no)

(organization running log)
 - (8) how well bottom plugged

RECEIVED


DEC 02 1987

Department of Natural Resources
Bureau of Land & Water Resources

DRILLERS REMARKS:

If well telescopes please sketch and show depths.

GROUND LEVEL

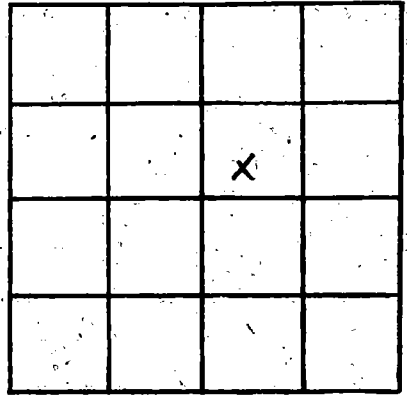

SECTION 2E

Please indicate well location X.

ADDITIONAL INFORMATION

If more than one screen,
show locations of each on sketch.