

MISSISSIPPI DEPARTMENT OF NATURAL RESOURCES  
Bureau of Land and Water Resources

P.O. Box 10631  
Jackson, Mississippi 39209  
WATER WELL DRILLERS LOG

COUNTY WELL LOCATED	Nauvoo	
WELL NUMBER	CODED	
J 2159		
DATE WELL COMPLETED		
2-3-89		

PERMIT NUMBER	0-493
NAME OF DRILLING FIRM	Bobby Beech's Well Works

NAME & MAILING ADDRESS OF LANDOWNER			
Rod Lerner			
Rt-3 Box			
Pass Christian MS 39571			
WELL LOCATION:	SEC	TOWNSHIP	RANGE
	29	7 N S	13 E
DISTANCE	DIRECTION	NEAREST TOWN	
	Miles	of	
OTHER LANDMARK			
WELL PURPOSE <u>Home</u> Irrigation, Municipal, Industrial, Fish Pond, etc.			

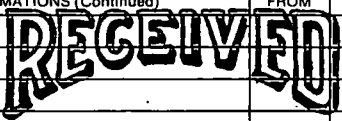
PUMP DATA		
PUMP TYPE (Circle One):		
Submersible,	Turbine,	<u>Jet</u> Flowing Well,
Other (Describe) _____		
POWER TYPE (Circle One):		
<u>Electric</u>	Tractor,	Diesel, Gasoline, Butane,
Other (Describe) _____		
Pump Capacity (GPM)	No. of Stages	Setting Depth
13	2	70 FT.
PUMP TEST		
Well yielded _____ GPM with		
a drawdown of _____ ft.		
after _____ hours of pumping		

WELL DATA		
Well Depth	Casing Diameter (In.)	Casing Length (Ft.)
237	2"	20
Type of Casing	Hole Depth	Depth to Static Water Level
PVC	237	47
TYPE OF COMPLETION: (Circle One or More):		
Gravel Packed,	Underreamed,	Telescoped,
<u>Natural Development</u>	Open Hole,	Other
(Describe) _____		
Top of Lap Pipe or Reduction in Casing		
FEET	IF TELESCOPED OR MORE THAN ONE SCREEN: USE BACK PAGE	

LOG DATA	
TYPE OF LOG RUN (Circle One):	
<u>No Log Run</u>	
Electric, Gamma Ray, Density, Sonic, Neutron,	
Other (Describe) _____	
Name of Organization Running Log	
Bobby Beech's Well Works	

SCREEN DATA		
Diameter - Inches	Length - Feet	Slot Size - Inches
2"	50	#8
Screen Type	Depth to Bottom - Feet	
Johnson Screen	237	

GEOLOGIC DATA (Office Use Only)			
Surface Elev.	Geologic Unit	Unit Thickness	Depth to Top
Subs. SWL	Date	Analysis	Aquifer Test
Driller's Remarks			
Fine well			

DESCRIPTION OF FORMATIONS ENCOUNTERED	FROM	TO	FORMATIONS (Continued)	FROM	TO
 JUN 6 1989 Department of Natural Resources Bureau of Land & Water Resources					
IF MORE SPACE IS NEEDED, USE BACK					

If well telescopes please sketch and show depths.

GROUND LEVEL


SECTION \_\_\_\_\_

Please indicate well location X.

ADDITIONAL INFORMATION

WATER

WELL

WELL

If more than one screen, show location of each on sketch.