

MISSISSIPPI DEPARTMENT OF NATURAL RESOURCES

Bureau of Land and Water Resources

P.O. Box 10631

Jackson, Mississippi 39209

WATER WELL DRILLERS LOG

COUNTY WELL LOCATED <i>Harrison</i>	
WELL NUMBER <i>2</i>	CODED
<i>2169</i>	
DATE WELL COMPLETED <i>Sept. 22-1989</i>	

PERMIT NUMBER <i>0239</i>
NAME OF DRILLING FIRM <i>McGill Pump & Wells</i>

NAME & MAILING ADDRESS OF LANDOWNER <i>Dedeaux</i>		
<i>Kila Delisle Rd.</i>		
<i>Pass Christian, Ms.</i>		
WELL LOCATION: SEC	TOWNSHIP	RANGE
<i>37</i>	<i>7 N</i>	<i>13 W</i>
DISTANCE	DIRECTION	NEAREST TOWN
<i>3</i> Miles	<i>North of Preville</i>	
OTHER LANDMARK		
WELL PURPOSE: <input checked="" type="checkbox"/> Home Irrigation, <input type="checkbox"/> Municipal, <input type="checkbox"/> Industrial, <input type="checkbox"/> Fish Pond, etc.		

PUMP DATA		
PUMP TYPE (Circle One): Submersible, Turbine, <input checked="" type="radio"/> Jet, <input type="radio"/> Flowing Well, Other (Describe) _____		
POWER TYPE (Circle One): <input checked="" type="radio"/> Electric, <input type="radio"/> Tractor, <input type="radio"/> Diesel, <input type="radio"/> Gasoline, <input type="radio"/> Butane, Other (Describe) _____ H/P _____		
Pump Capacity (GPM)	No. of Stages	Setting Depth
<i>11</i>	<i>2</i>	<i>60'</i> FT.
PUMP TEST		
Well yielded <i>11</i> GPM with a drawdown of <i>10</i> ft. after <i>1</i> hours of pumping		

WELL DATA		
Well Depth <i>520'</i>	Casing Diameter (In.) <i>2"</i>	Casing Length (Ft.) <i>20'</i>
Type of Casing <i>PVC</i>	Hole Depth <i>520'</i>	Depth to Static Water Level <i>30'</i>
TYPE OF COMPLETION: (Circle One or More): <input checked="" type="checkbox"/> Gravel Packed, <input type="checkbox"/> Underreamed, <input type="checkbox"/> Telescoped, <input checked="" type="checkbox"/> Natural Development, <input type="checkbox"/> Open Hole, <input type="checkbox"/> Other (Describe) _____		
Top of Lap Pipe or Reduction in Casing		
FEET <input type="checkbox"/> IF TELESCOPED OR MORE THAN ONE SCREEN: USE BACK PAGE		

LOG DATA	
TYPE OF LOG RUN (Circle One): Electric, Gamma Ray, Density, Sonic, <input checked="" type="radio"/> No Log Run, Neutron, Other (Describe) _____	
Name of Organization Running Log	

SCREEN DATA		
Diameter - Inches <i>2"</i>	Length - Feet <i>10'</i>	Slot Size - Inches <i>1000µ</i>
Screen Type <i>PVC</i>	Depth to Bottom - Feet <i>520</i>	

GEOLOGIC DATA (Office Use Only)			
Surface Elev.	Geologic Unit	Unit Thickness	Depth to Top
Subs. SWL	Date	Analysis	Aquifer Test


Driller's Remarks

DESCRIPTION OF FORMATIONS ENCOUNTERED	FROM	TO
<i>mud</i>	<i>0</i>	<i>40</i>
<i>sand</i>	<i>40</i>	<i>50</i>
<i>mud</i>	<i>50</i>	<i>190</i>
<i>sand</i>	<i>190</i>	<i>240</i>
<i>mud</i>	<i>240</i>	<i>350</i>
<i>sand</i>	<i>350</i>	<i>380</i>
<i>mud</i>	<i>380</i>	<i>470</i>
<i>sand</i>	<i>470</i>	<i>520</i>

FORMATIONS (Continued)	FROM	TO
RECEIVED		
AUG 16 1990		
Department of Natural Resources Bureau of Land & Water Resources		
IF MORE SPACE IS NEEDED, USE BACK		

If well telescopes please sketch and show depths.

GROUND LEVEL

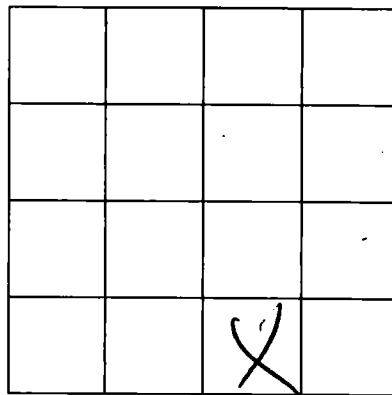

SECTION _____

Please indicate well location X.

ADDITIONAL INFORMATION

Lined area for additional information.

If more than one screen, show location of each on sketch.