

MISSISSIPPI DEPARTMENT OF NATURAL RESOURCES
Bureau of Land and Water Resources

P.O. Box 10631

Jackson, Mississippi 39209

WATER WELL DRILLERS LOG

COUNTY WELL LOCATED <i>Harrison</i>	
WELL NUMBER <i>J 2/92</i>	CODED
DATE WELL COMPLETED <i>8-18-88</i>	

PERMIT NUMBER
Coastal Drilling & Service Co. 8456 Woolmarket Biloxi Road Biloxi, Mississippi 39532

NAME & MAILING ADDRESS OF LANDOWNER <i>Larry Gagnon</i> <i>1040 Ymerge Avenue</i> <i>Pass Christian, 39571</i>		
WELL LOCATION: SEC	TOWNSHIP	RANGE
<i>Harrison 24</i>	<i>7 N</i>	<i>13 E</i>
DISTANCE	DIRECTION	NEAREST TOWN
<i>2</i> Miles	<i>N</i>	of <i>DuLeale</i>
OTHER LANDMARK <i>Ms. Power Line</i>		
WELL PURPOSE: Home, Irrigation, Municipal, Industrial, Fish Pond, etc. <i>Home</i>		

PUMP DATA		
PUMP TYPE (Circle One): <input checked="" type="radio"/> Submersible <input type="radio"/> Turbine, <input type="radio"/> Jet <input type="radio"/> Flowing Well, Other (Describe) _____		
POWER TYPE (Circle One): <input checked="" type="radio"/> Electric, <input type="radio"/> Tractor, <input type="radio"/> Diesel, <input type="radio"/> Gasoline, <input type="radio"/> Butane, Other (Describe) _____		
Pump Capacity (GPM) <i>10</i>	No. of Stages <i>7</i>	Setting Depth <i>100</i> FT.
PUMP TEST Well yielded _____ <i>10</i> GPM with a drawdown of _____ <i>2</i> ft. after _____ <i>2</i> hours of pumping		

WELL DATA		
Well Depth <i>540'</i>	Casing Diameter (In.) <i>4 X 2</i>	Casing Length (Ft.) <i>525'</i>
Type of Casing <i>PVC</i>	Hole Depth <i>540</i>	Depth to Static Water Level <i>80'</i>
TYPE OF COMPLETION: (Circle One or More): <input checked="" type="radio"/> Gravel Packed, <input type="radio"/> Underreamed, <input type="radio"/> Telescoped, <input checked="" type="radio"/> Natural Development, <input type="radio"/> Open Hole, <input type="radio"/> Other (Describe) _____		
Top of Lap Pipe or Reduction in Casing FEET IF TELESKOPED OR MORE THAN ONE SCREEN: USE BACK PAGE		

LOG DATA	
TYPE OF LOG RUN (Circle One): No Log Run, Electric, Gamma Ray, Density, Sonic, Neutron, Other (Describe) _____	
Name of Organization Running Log	

SCREEN DATA		
Diameter - Inches <i>2"</i>	Length - Feet <i>1.5</i>	Slot Size - Inches <i>.008</i>
Screen Type <i>PVC</i>	Depth to Bottom - Feet <i>540</i>	

GEOLOGIC DATA (Office Use Only)			
Surface Elev.	Geologic Unit	Unit Thickness	Depth to Top
Subs. SWL	Date	Analysis	Aquifer Test
Driller's Remarks <i>None</i>			

DESCRIPTION OF FORMATIONS ENCOUNTERED	FROM	TO	FORM	TO
<i>top soil</i>	<i>1'</i>	<i>3'</i>		
<i>Red sand</i>	<i>3'</i>	<i>14'</i>		
<i>White sand</i>	<i>14'</i>	<i>28'</i>		
<i>Soft Blue Clay</i>	<i>28'</i>	<i>60'</i>		
<i>Hard Blue Clay</i>	<i>60'</i>	<i>300'</i>		
<i>fine water sand</i>	<i>300'</i>	<i>315'</i>		
<i>Hard Blue Clay</i>	<i>315'</i>	<i>450'</i>		
<i>fine water sand</i>	<i>450'</i>	<i>520'</i>		
<i>Coarse water sand</i>	<i>520'</i>	<i>540'</i>		


RECEIVED

FEB 10 1992

Dept. of Environmental Quality
Bureau of Land & Water Resources

IF MORE SPACE IS NEEDED, USE BACK

If well telescopes please sketch and show depths:

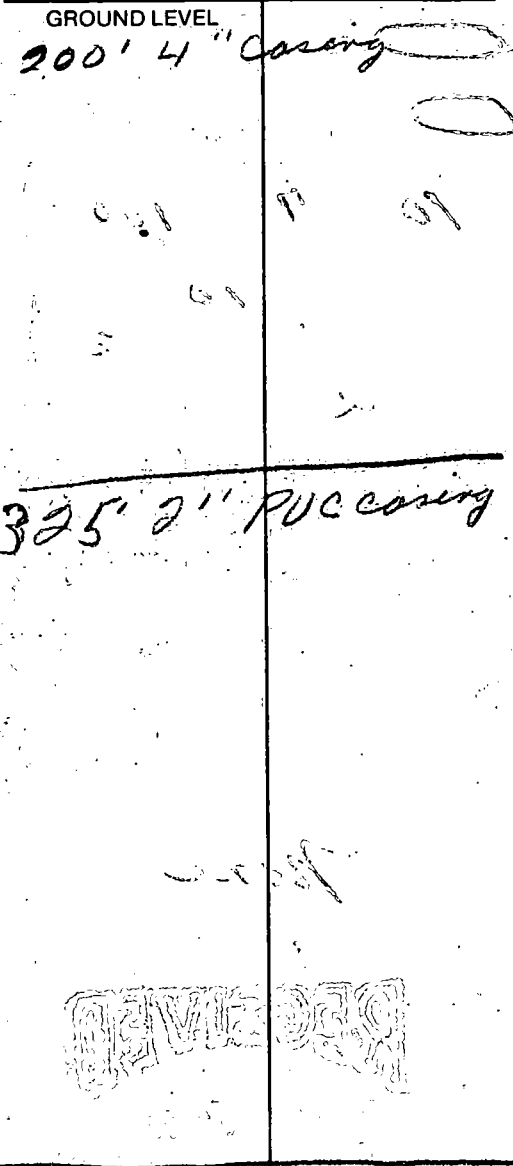

SECTION _____

Please indicate well location X.

ADDITIONAL INFORMATION

Handwritten notes and data in the additional information section, including dates like '11-1-89' and '11-17-89', and other illegible text.

If more than one screen, show location of each on sketch.