


If well telescopes please sketch and show depths.

GROUND LEVEL

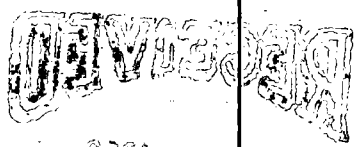

Handwritten notes or markings at the bottom of the sketch area.

If more than one screen, show location of each on sketch.

SECTION _____

Please indicate well location X.

ADDITIONAL INFORMATION

Lined area for providing additional information.