

MISSISSIPPI DEPARTMENT OF ENVIRONMENTAL QUALITY
Bureau of Land and Water Resources

P. O. Box 10631
Jackson, MS 39289-0631
WATER WELL DRILLERS LOG

COUNTY WELL LOCATED
Harrison

WELL NUMBER CODED
J 2234

DATE WELL COMPLETED
8-27-93

PERMIT NUMBER
D-239

NAME OF DRILLING FIRM
McGill

Pump & Well

NAME & MAILING ADDRESS OF LANDOWNER
Bruce Stinson
26150 Walnut Rd.

WELL LOCATION: SEC **34** TOWNSHIP **7** RANGE **N 13 E**
S **13** W

DISTANCE _____ MILES _____ OF _____ DIRECTION _____ NEAREST TOWN _____

OTHER LANDMARK _____

WELL PURPOSE Home Irrigation, Municipal, Industrial, Fish Pond, etc.

PUMP DATA

PUMP TYPE (Circle One):
Submersible, Turbine, Jet, Flowing Well,
Other (Describe) _____

POWER TYPE (Circle One):
 Electric, Tractor, Diesel, Gasoline, Butane,
Other (Describe) _____ H/P **1**

Pump Capacity (GPM) **15** No. of Stages **2** Setting Depth **60** FT.

PUMP TEST

Well yielded **10** GPM with
a drawdown of **10** ft.
after **24** hours of pumping

WELL DATA

Well Depth 535	Casing Diameter (In.) 2	Casing Length (Ft.) 525
Type of Casing PVC	Hole Depth 535	Depth to Static Water Level 40

TYPE OF COMPLETION: (Circle One or More):
 Gravel Packed, Underreamed, Telescoped,
 Natural Development, Open Hole, Other
(Describe) _____

Top of Lap Pipe or Reduction in Casing _____

FEET IF TELESCOPED OR MORE THAN ONE SCREEN: USE BACK PAGE

LOG DATA

TYPE OF LOG RUN (Circle One): No Log Run,
Electric, Gamma Ray, Density, Sonic, Neutron,
Other (Describe) _____

Name of Organization Running Log _____

SCREEN DATA

Diameter - Inches 2	Length - Feet 10	Slot Size - Inches 6
Screen Type PVC	Depth to Bottom - Feet 535	

GEOLOGIC DATA (Office Use Only)

Surface Elev.	Geologic Unit	Unit Thickness	Depth to Top
Subs. SWL	Date	Analysis	Aquifer Test

Driller's Remarks _____

DESCRIPTION OF FORMATIONS ENCOUNTERED	FROM	TO
mud	0	120
mud - sand	120	140
sand - mud - sand	140	340
sand - mud	340	360
mud	360	420
mud - sand	420	460
sand - mud	460	500
mud - 20' sand	500	535

FORMATIONS (Continued)

RECEIVED

FEB 09 1994

Dept. of Environmental Quality
Office of Land & Water Resources

IF MORE SPACE IS NEEDED, USE BACK

If well telescopes please sketch and show depths.


GROUND LEVEL

SECTION _____

Please indicate well location X.

ADDITIONAL INFORMATION

(Faint handwritten text, possibly "213")

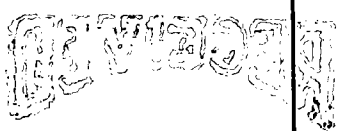

(Faint handwritten text)

(Faint handwritten text)

If more than one screen, show location of each on sketch.