

MISSISSIPPI DEPARTMENT OF ENVIRONMENTAL QUALITY

Office of Land and Water Resources

P. O. Box 10631
Jackson, MS 39289-0631
WATER WELL DRILLERS LOG

COUNTY WELL LOCATED
HARRISON

WELL NUMBER **J 2258** CODED

DATE WELL COMPLETED
3-6-95

PERMIT NUMBER
0239

NAME OF DRILLING FIRM
McGill Pump & Well

NAME & MAILING ADDRESS OF LANDOWNER
ROBBIE ROBINSON

SERENITY ACRES LOT 25

Bill Barrette

WELL LOCATION SEC **25** TOWNSHIP **7** RANGE **N 13 E**
S W

DISTANCE _____ MILES _____ OF _____

DIRECTION _____ NEAREST TOWN _____

OTHER LANDMARK _____

WELL PURPOSE Home Irrigation, Municipal, Industrial, Fish Pond, etc.

PUMP DATA

PUMP TYPE (Circle One):
Submersible, Turbine, Jet, Flowing Well,
Other (Describe) _____

POWER TYPE (Circle One):
Electric, Tractor, Diesel, Gasoline, Butane,
Other (Describe) _____ H/P _____

Pump Capacity (GPM) _____ No. of Stages _____ Setting Depth _____ FT.

NOT furnished

PUMP TEST

Well yielded _____ GPM with
a drawdown of _____ ft.
after _____ hours of pumping

WELL DATA

Well Depth **500** Casing Diameter (In) **2"** Casing Length (Ft) **450**

Type of Casing **PVC** Hole Diameter **1 7/8"** Depth to Static Water Level **80**

LOG DATA

TYPE OF LOG RUN (Circle One):
Electric, Gamma Ray, Density, Sonic, Neutron,
Other (Describe) _____ **No Log Run**

Name of Organization Running Log _____

TYPE OF COMPLETION: (Circle One or More):
Gravel Packed, Underreamed, Telescoped,
Natural Development Open Hole, Other _____
(Describe) _____

WELL GROUTED TO A DEPTH OF **10** FEET
Type Grout (circle one): Cement, Bentonite, or Mix

GEOLOGIC DATA (Office Use Only)

Surface Elev.	Geologic Unit	Unit Thickness	Depth to Top
Subs. SWL	Date	Analysis	Aquifer Test

SCREEN DATA

Diameter - Inches **2"** Length - Feet **20'** Slot Size - Inches **.006**

Screen Type **PVC** Depth to Bottom **450**

Driller's Remarks _____

Top of Lap Pipe or Reduction in Casing _____


FEET IF TELESCOPED OR MORE THAN ONE SCREEN: USE BACK PAGE

DESCRIPTION OF FORMATIONS ENCOUNTERED	FROM	TO
mud-sand	0	20
sand	20	80
sand-mud	80	100
mud	100	340
sand-mud	340	400
mud	400	440
sand	440	500

FORMATIONS (Continued)	FROM	TO
RECEIVED		
MAR 30 1995		
Dept. of Environmental Quality Office of Land & Water Resources		
IF MORE SPACE IS NEEDED, USE BACK		

If well telescopes please sketch and show depths.

GROUND LEVEL

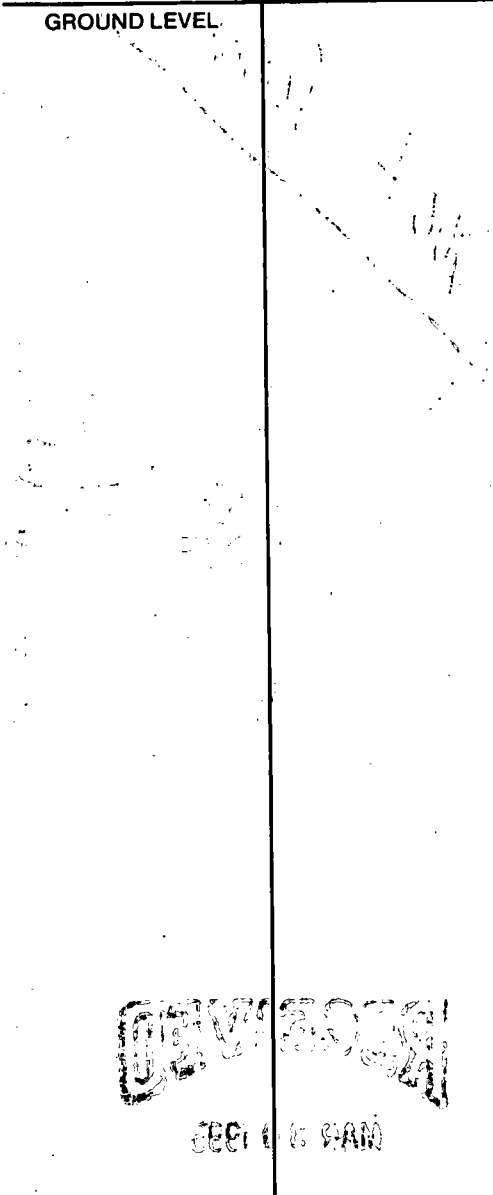

DEWEESON

CEC 111 9111

Handwritten notes at the bottom of the sketch area, including "111" and "9111".

If more than one screen, show location of each on sketch.

SECTION _____
Please indicate well location X

ADDITIONAL INFORMATION

Handwritten notes and scribbles in the additional information section, including "111" and "9111".