

MISSISSIPPI DEPARTMENT OF ENVIRONMENTAL QUALITY

Office of Land and Water Resources

P. O. Box 10631
Jackson, MS 39289-0631
WATER WELL DRILLERS LOG

COUNTY WELL LOCATED
HARRISON

WELL NUMBER **2269** CODED

DATE WELL COMPLETED
12-1-94

PERMIT NUMBER
0239

NAME OF DRILLING FIRM
McGILL PUMP WELL

NAME & MAILING ADDRESS OF LANDOWNER
BILL GARRETT

LOT #26 Serenity

PASS CHRISTIAN, MS

WELL LOCATION SEC TOWNSHIP RANGE **27 7 N 13 E W**

DISTANCE _____ MILES _____ of _____

DIRECTION _____ NEAREST TOWN _____

OTHER LANDMARK _____

WELL PURPOSE Home, Irrigation, Municipal, Industrial, Fish Pond, etc.

PUMP DATA

PUMP TYPE (Circle One):
Submersible, Turbine, Jet, Flowing Well,
Other (Describe) _____

POWER TYPE (Circle One):
Electric, Tractor, Diesel, Gasoline, Butane,
Other (Describe) _____ H/P _____

Pump Capacity (GPM) _____ No. of Stages _____ Setting Depth _____ FT.

PUMP TEST

Well yielded _____ GPM with
a drawdown of _____ ft.
after _____ hours of pumping

WELL DATA

Well Depth 400'	Casing Diameter (In.) 2"	Casing Length (Ft.) 380'
Type of Casing PVC	Hole Depth 400'	Depth to Static Water Level _____

TYPE OF COMPLETION: (Circle One or More):
Gravel Packed, Underreamed, Telescoped,
Natural Development, Open Hole, Other _____

WELL GROUTED TO A DEPTH OF **10 FEET**
Type Grout (circle one): Cement, Bentonite, or Mix

LOG DATA

TYPE OF LOG RUN (Circle One): No Log Run
Electric, Gamma Ray, Density, Sonic, Neutron,
Other (Describe) _____

Name of Organization Running Log _____

SCREEN DATA

Diameter - Inches 2"	Length - Feet 20'	Slot Size - Inches .006
Screen Type PVC	Depth to Bottom - Feet 380'	

GEOLOGIC DATA (Office Use Only)

Surface Elev.	Geologic Unit	Unit Thickness	Depth to Top
Subs. SWL	Date	Analysis	Aquifer Test

Driller's Remarks _____

Top of Lap Pipe or Reduction in Casing _____

FEET IF TELESCOPED OR MORE THAN ONE SCREEN: USE BACK PAGE

DESCRIPTION OF FORMATIONS ENCOUNTERED	FROM	TO
mud	0	20
sand	20	80
SAND - mud	80	100
mud	100	340
sand	340	400

FORMATIONS (Continued)

FORMATIONS (Continued)	FROM	TO

RECEIVED


MAR 30 1995

Dept. of Environmental Quality
Office of Land & Water Resources

IF MORE SPACE IS NEEDED, USE BACK

If well telescopes please sketch and show depths.

GROUND LEVEL

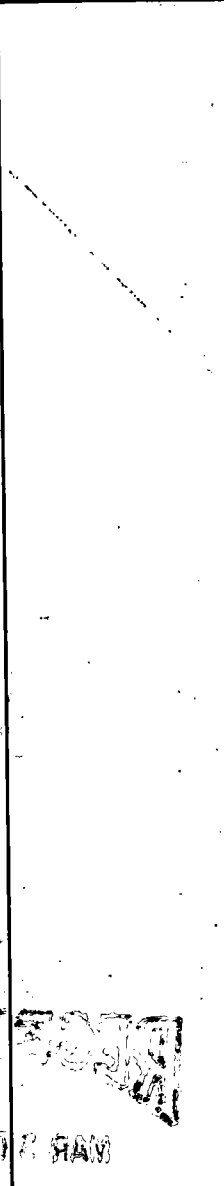

WATER RESOURCES DIVISION
U.S. GEOLOGICAL SURVEY

MAR 2 1982

THIS FORM IS TO BE USED FOR RECORDING DATA FROM WELL TELESCOPES

If more than one screen, show location of each on sketch.

1	2	3	4
5	6	7	8
9	10	11	12
13	14	15	16

SECTION _____

Please indicate well location X.

ADDITIONAL INFORMATION

Handwritten notes and a circled 'S' are visible in the 'ADDITIONAL INFORMATION' section. The rest of the section contains horizontal lines for further text.