

MISSISSIPPI DEPARTMENT OF ENVIRONMENTAL QUALITY

Office of Land and Water Resources

P. O. Box 10631
Jackson, MS 39289-0631
WATER WELL DRILLERS LOG

COUNTY WELL LOCATED
WELL NUMBER CODED PERMIT NUMBER
DATE WELL COMPLETED

PERMIT NUMBER
NAME OF DRILLING FIRM

NAME & MAILING ADDRESS OF LANDOWNER
WELL LOCATION
DISTANCE DIRECTION NEAREST TOWN
OTHER LANDMARK
WELL PURPOSE

PUMP DATA
PUMP TYPE (Circle One):
POWER TYPE (Circle One):
Pump Capacity (GPM) No. of Stages Setting Depth
PUMP TEST
Well yielded _____ GPM with
a drawdown of _____ ft.
after _____ hours of pumping


WELL DATA
Well Depth Casing Diameter (In.) Casing Length (Ft.)
Type of Casing Hole Depth Depth to Static Water Level
TYPE OF COMPLETION: (Circle One or More):
WELL GROUTED TO A DEPTH OF _____ FEET
Type Grout (circle one):

LOG DATA
TYPE OF LOG RUN (Circle One):
Name of Organization Running Log

SCREEN DATA
Diameter - Inches Length - Feet Slot Size - Inches
Screen Type Depth to Bottom - Feet

GEOLOGIC DATA (Office Use Only)
Surface Elev. Geologic Unit Unit Thickness Depth to Top
Subs. SWL Date Analysis Aquifer Test
Driller's Remarks
Top of Lap Pipe or Reduction in Casing
FEET IF TELESKOPED OR MORE THAN ONE SCREEN: USE BACK PAGE

DESCRIPTION OF FORMATIONS ENCOUNTERED	FROM	TO	FORMATIONS (Continued)	FROM	TO

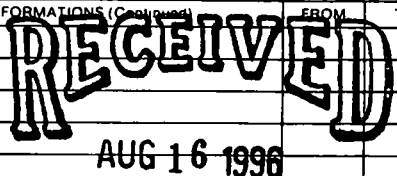

Dept. of Environmental Quality
Office of Land & Water Resources

IF MORE SPACE IS NEEDED, USE BACK

