

MISSISSIPPI DEPARTMENT OF ENVIRONMENTAL QUALITY

Office of Land and Water Resources

P. O. Box 10631
Jackson, MS 39289-0631
WATER WELL DRILLERS LOG

COUNTY WELL LOCATED
Harrison
WELL NUMBER CODED
F 2301
DATE WELL COMPLETED
11-19-96

PERMIT NUMBER
0404
NAME OF DRILLING FIRM
*Lyman Well Co.
Huepport ms.*

NAME & MAILING ADDRESS OF LANDOWNER
*Fenton Community Church
P.O. Box 455
Pass Christian, ms.*
WELL LOCATION SEC TOWNSHIP RANGE
19 7 N 13 E
DISTANCE DIRECTION NEAREST TOWN
Miles of
OTHER LANDMARK
WELL PURPOSE Home Irrigation, Municipal, Industrial, Fish Pond, etc.

PUMP DATA
PUMP TYPE (Circle One):
Submersible, Turbine, Jet Flowing Well,
Other (Describe) _____
POWER TYPE (Circle One):
Electric Tractor, Diesel, Gasoline, Butane,
Other (Describe) _____ H/P 1
Pump Capacity (GPM) No. of Stages Setting Depth
_____ FT.
PUMP TEST
Well yielded _____ GPM with
a drawdown of _____ ft.
after _____ hours of pumping

WELL DATA
Well Depth Casing Diameter (in) Casing Length (ft.)
325' 2" 315'
Type of Casing Hole Depth Depth to Static Water Level
PVC 7'
TYPE OF COMPLETION: (Circle One or More):
Natural Development Gravel Packed, Underreamed, Telescoped,
Open Hole, Other
(Describe) _____
WELL GROUTED TO A DEPTH OF _____ FEET
Type Grout (circle one): Cement, Bentonite, or Mix

LOG DATA
TYPE OF LOG RUN (Circle One): No Log Run,
Electric, Gamma Ray, Density, Sonic, Neutron,
Other (Describe) _____
Name of Organization Running Log

SCREEN DATA
Diameter - Inches Length - Feet Slot Size - Inches
2" 10'
Screen Type Depth to Bottom - Feet
PVC


GEOLOGIC DATA (Office Use Only)
Surface Elev. Geologic Unit Unit Thickness Depth to Top
Subs. SWL Date Analysis Aquifer Test
Driller's Remarks
Top of Lap Pipe or Reduction in Casing
FEET IF TELESCOPED OR MORE THAN ONE SCREEN: USE BACK PAGE

DESCRIPTION OF FORMATIONS ENCOUNTERED	FROM	TO

RECEIVED
DEC 09 1996
Dept. of Environmental Quality
Office of Land & Water Resources
IF MORE SPACE IS NEEDED, USE BACK

If well telescopes please sketch and show depths.

GROUND LEVEL

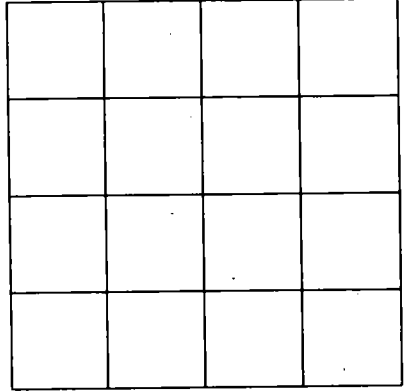

SECTION _____

Please indicate well location X.

ADDITIONAL INFORMATION

If more than one screen, show location of each on sketch.