

**MISSISSIPPI DEPARTMENT OF ENVIRONMENTAL QUALITY**

Office of Land and Water Resources

P. O. Box 10631  
Jackson, MS 39289-0631  
**WATER WELL DRILLERS LOG**

COUNTY WELL LOCATED <b>HARRISON</b>	
WELL NUMBER <b>52328</b>	CODED
DATE WELL COMPLETED <b>11-11-97</b>	

PERMIT NUMBER <b>0-039</b>
NAME OF DRILLING FIRM <b>Mr. Dill</b>

NAME & MAILING ADDRESS OF LANDOWNER <b>Carl Ladner</b>			
<b>26032 Elmerladner Rd</b>			
<b>Pass Cr., Ms.</b>			
WELL LOCATION	SEC	TOWNSHIP	RANGE
	<b>11</b>	<b>7</b>	<b>13</b>
		<b>N</b>	<b>E</b>
		<b>S</b>	<b>W</b>
DISTANCE	DIRECTION	NEAREST TOWN	
OTHER LANDMARK			
WELL PURPOSE: <input checked="" type="radio"/> Home Irrigation, <input type="radio"/> Municipal, <input type="radio"/> Industrial, <input type="radio"/> Fish Pond, etc.			

<b>PUMP DATA</b>			
PUMP TYPE (Circle One): Submersible, Turbine, Jet, Flowing Well, Other (Describe) _____			
POWER TYPE (Circle One): Electric, Tractor, Diesel, Gasoline, Butane, Other (Describe) _____ H/P _____			
Pump Capacity (GPM)	No. of Stages	Setting Depth	
<b>N/A</b>			
PUMP TEST			
Well yielded _____ GPM with a drawdown of _____ ft. after _____ hours of pumping			

<b>WELL DATA</b>		
Well Depth <b>340'</b>	Casing Diameter (In.) <b>2</b>	Casing Length (Ft.) <b>320</b>
Type of Casing <b>PUC</b>	Hole Depth <b>340</b>	Depth to Static Water Level <b>60</b>

<b>LOG DATA</b>	
TYPE OF LOG RUN (Circle One): Electric, Gamma Ray, Density, Sonic, Neutron, Other (Describe) _____	
Name of Organization Running Log	

TYPE OF COMPLETION: (Circle One or More): Gravel Packed, Underreamed, Telescoped, Natural Development, Open Hole, Other (Describe) _____			
WELL GROUTED TO A DEPTH OF <b>10</b> FEET Type Grout (circle one): Cement, Bentonite, or Mix			

<b>GEOLOGIC DATA (Office Use Only)</b>			
Surface Elev.	Geologic Unit	Unit Thickness	Depth to Top
Subs. SWL	Date	Analysis	Aquifer Test

<b>SCREEN DATA</b>		
Diameter - Inches <b>2</b>	Length - Feet <b>20</b>	Slot Size - Inches <b>1006</b>
Screen Type <b>PUC</b>		Depth to Bottom - Feet <b>340</b>


Driller's Remarks	
Top of Lap Pipe or Reduction in Casing	
FEET	IF TELESCOPED OR MORE THAN ONE SCREEN: USE BACK PAGE

DESCRIPTION OF FORMATIONS ENCOUNTERED	FROM	TO
<b>Mud</b>	<b>0</b>	<b>280</b>
<b>Dam</b>	<b>280</b>	<b>290</b>
<b>mud</b>	<b>290</b>	<b>320</b>
<b>Dam</b>	<b>320</b>	<b>340</b>

FORMATIONS (Continued)	FROM	TO
<b>RECEIVED</b>		
<b>AUG 06 1999</b>		
Dept. of Environmental Quality Office of Land & Water Resources		
IF MORE SPACE IS NEEDED, USE BACK		

If well telescopes please sketch and show depths.

GROUND LEVEL

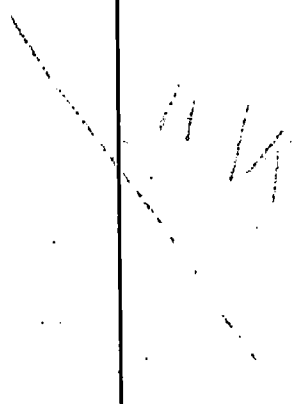


SECTION \_\_\_\_\_

Please indicate well location X-

ADDITIONAL INFORMATION

Handwritten notes on lined paper:

1. ...

2. ...

DRIVE

0000 10 0000

Vertical text, possibly a date or time stamp: 0000 10 0000

If more than one screen, show location of each on sketch.