

**MISSISSIPPI DEPARTMENT OF ENVIRONMENTAL QUALITY**

Office of Land and Water Resources

P. O. Box 10631  
Jackson, MS 39289-0631  
**WATER WELL DRILLERS LOG**

COUNTY WELL LOCATED <b>Harrison</b>	
WELL NUMBER <b>J-2335</b>	CODED
DATE WELL COMPLETED <b>7/15/99</b>	

PERMIT NUMBER <b>0-239</b>
NAME OF DRILLING FIRM <b>mc hill pump well</b>

NAME & MAILING ADDRESS OF LANDOWNER <b>Cremie Herman Sadler</b>			
WELL LOCATION <b>Subpat, ms 39503</b>			
SEC <b>25</b>	TOWNSHIP <b>7 N S</b>	RANGE <b>13 E W</b>	
DISTANCE _____ Miles	DIRECTION	NEAREST TOWN	
OTHER LANDMARK			
WELL PURPOSE (Home Irrigation, Municipal, Industrial, Fish Pond, etc.) <b>Home</b>			

PUMP DATA		
PUMP TYPE (Circle One): Submersible, Turbine, <b>Jet</b> Flowing Well, Other (Describe)		
POWER TYPE (Circle One): <b>Electric</b> Tractor, Diesel, Gasoline, Butane, Other (Describe) <b>H/P</b>		
Pump Capacity (GPM) <b>10</b>	No. of Stages <b>2</b>	Setting Depth <b>80</b> FT.
PUMP TEST		
Well yielded <b>10</b> GPM with a drawdown of <b>15</b> ft. after <b>5</b> hours of pumping		

WELL DATA		
Well Depth <b>160</b>	Casing Diameter (In.) <b>2"</b>	Casing Length (Ft.) <b>160</b>
Type of Casing <b>pvc</b>	Hole Depth <b>160</b>	Depth to Static Water Level <b>120</b>
TYPE OF COMPLETION: (Circle One or More): Gravel Packed, Underreamed, Telescoped, <b>Natural Development</b> , Open Hole, Other		

LOG DATA	
TYPE OF LOG RUN (Circle One): <b>Electric</b> Gamma Ray, Density, Sonic, Neutron, Other (Describe) <b>Hand written</b>	
Name of Organization Running Log	

WELL GROUTED TO A DEPTH OF <b>10</b> FEET Type Grout (circle one): Cement, Bentonite, or Mix
---

GEOLOGIC DATA (Office Use Only)			
Surface Elev.	Geologic Unit	Unit Thickness	Depth to Top
Subs. SWL	Date	Analysis	Aquifer Test
Driller's Remarks			
Top of Lap Pipe or Reduction in Casing <b>FEET</b> IF TELESCOPED OR MORE THAN ONE SCREEN: USE BACK PAGE			

SCREEN DATA		
Diameter - Inches <b>2"</b>	Length - Feet <b>20'</b>	Slot Size - Inches <b>.006</b>
Screen Type <b>pvc</b>	Depth to Bottom - Feet <b>160</b>	


DESCRIPTION OF FORMATIONS ENCOUNTERED	FROM	TO	FORMATIONS (Continued)	
			FROM	TO
<b>grud sand</b>	<b>20</b>	<b>120</b>		
	<b>140</b>	<b>160</b>		

**REC'D JUN 25 2001**

IF MORE SPACE IS NEEDED, USE BACK

If well telescopes please sketch and show depths.

Handwritten notes at the top right, including "7-20-0", "Kell 200", "Blaw", and "p/p/r/r".

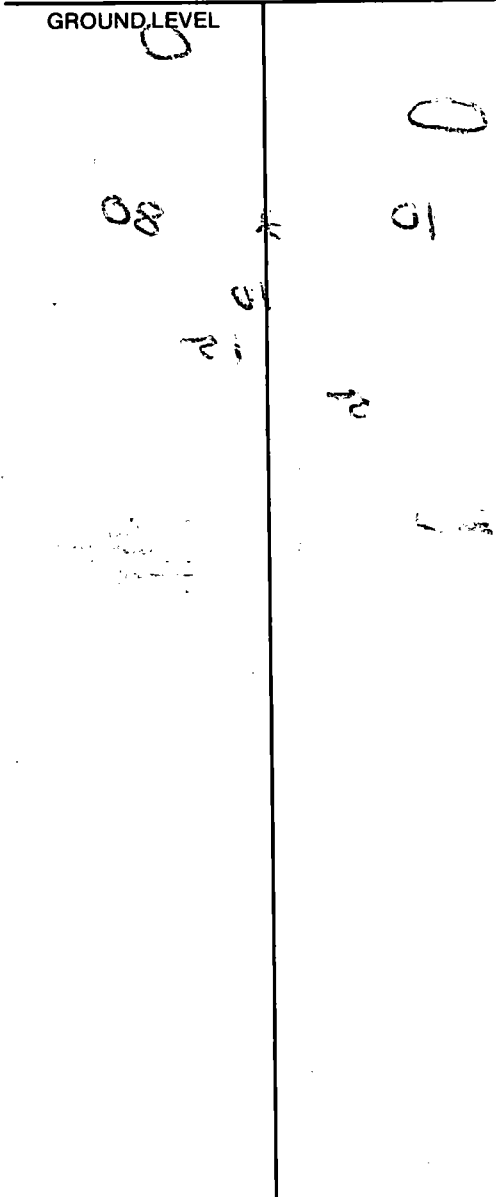


SECTION \_\_\_\_\_

Please indicate well location X.

ADDITIONAL INFORMATION

---



---



If more than one screen, show location of each on sketch.