

**HARRISON**  
**J**  
**8-27-80**

MISSISSIPPI  
 BOARD OF WATER COMMISSIONERS  
 416 North State Street  
 Jackson, Mississippi 39201

**WATER WELL DRILLERS LOG**

Aug. 27 - 1980 McNeil Well Works Harrison  
 date well completed firm name county well located

LANDOWNER: Jack Derrington  
 264-5415  
 Hattiesburg Ms.  
 (mailing address)

description of formations encountered	from	to
clay	0	20
blue mud	20	60
sand - mud	60	80
blue mud	80	120
sand - mud	120	160
L. sand	160	185
choice sand	185	200

WELL LOCATION: Shoreline Park  
 sec. 30 T. 7 N R. 13 E  
 4 miles W of Pass Christian  
 (distance) (direction) (nearest town)

WELL PURPOSE:  
 (home, irrigation, municipal, industrial)

WELL COMPLETION DATA:

(1) diameter (inches) 2"  
 (2) total depth (feet) 200'  
 (3) static water level (feet) 2' below top of ground.  
 (4) casing PVC 190'  
 (material) (depth)  
 (size) If telescope see back.  
 (5) screen 10'  
 (length) (depth to top)  
 2" plastic  
 (size) (material)  
 (6) pump 15  
 (HP) (yield gpm)  
 (type power)  
 (7) electric log (yes or no)  
 (organization running log)  
 (8) how well bottom plugged sand  
 Shark.

Had his own.

DEPT. OF NATURAL RESOURCES  
 BUREAU OF LAND & WATER RESOURCES

SEP - 7 1982


**RECEIVED**

DRILLERS REMARKS:

If well telescopes please sketch and show depths.

W.02199AM  
L  
08-55-2

GROUND LEVEL

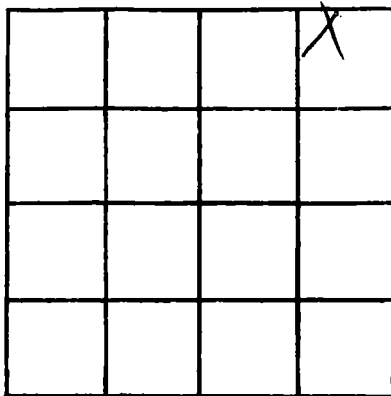

SECTION 30

Please indicate well location X.

ADDITIONAL INFORMATION

If more than one screen, show locations of each on sketch.