

HAR

* 23

8451107

WATER WELL DRILLERS LOG

CODED

8-26-60

Date: Aug. 26, 1960, Driller: C. T. Switzer Well Co. County Harrison

(Name)

(1) Owner of Land: Mrs. Johnnie Maho
 Route 1 - Sulphur - Christian & Red
Creek Rd. 2 mile S of intersection
with County 2 drum Road.
 (Address)

(2) Location: 1/4, 1/4, Sec. 21 T. 7 R. 12
8 miles N. of Black
 (distance) (direction) (Nearest Town)

(3) Topography: (Hilly) (Flat) (Level)

(4) Purpose of Well: domestic
 (Domestic Irrigation
 Municipal, Industrial, Other)

Description & Color of Materials Sand, Clay, Red Clay, Shell, etc.	Thick- ness Feet	Depth Feet
Clay	0	39
sand	39	44
Clay	44	102
sand	102	110
Clay	110	144
sand	144	150
Clay	150	158
sand	158	167
Clay	167	248
sand	248	304

Information upon completion of well:

(1) Diameter 2 inches.

(2) Total Depth 304 feet.

(3) Water Level ground level feet below top of ground.

(4) Cased to 304', Size 2"

(5) Screen: Size 2", Length 10' 8 3/4" SS.


(6) Were any formations sealed against pollution?
 yes, no.

If YES depth of formation 10 feet

Why Health dept. requirement

Drillers Remarks:

CODED

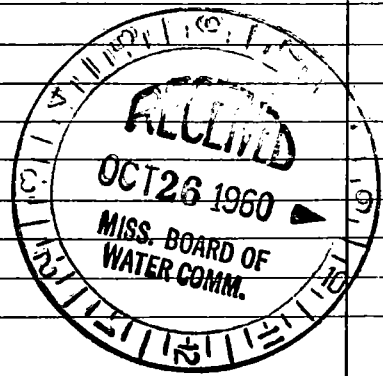

(Use Back Side)

Well No.

0000

1950

1951

1952

1953