

HAR.
K24

E450511

WATER WELL DRILLERS LOG

CODED

10-26-60

Date: Oct. 26, 1960 Driller C. T. Switzer Well Co. County Harrison
(Name)

(1) Owner of Land: C. W. Brady
West end of Landon Rd.
(Name)
(Address)
(2) Location: 1/4, 1/4, Sec. 9 T. 7 R. 12
4 miles N, of Kemp Beach
(distance) (direction) (Nearest Town)
(3) Topography: ✓
(Hilly) (Flat) (Level)
(4) Purpose of Well: Domestic
(Domestic Irrigation
Municipal, Industrial, Other)


Description & Color of Materials Sand, Clay, Red Clay, Shell, etc.	Thick- ness Feet	Depth Feet
<u>Sand</u>	<u>0</u>	<u>44</u>
<u>Clay</u>	<u>44</u>	<u>145</u>
<u>sand</u>	<u>145</u>	<u>156</u>
<u>Clay</u>	<u>156</u>	<u>210</u>
<u>Shale</u>	<u>210</u>	<u>231</u>
<u>Clay</u>	<u>231</u>	<u>346</u>
<u>sand</u>	<u>346</u>	<u>377</u>

Information upon completion of well:

(1) Diameter 2 inches.
(2) Total Depth 377 feet.
(3) Water Level -20'6" feet below top of ground.
(4) Cased to 377', Size 2"
(5) Screen: Size 1/8 ga., Length 10'
(6) Were any formations sealed against pollution?
✓ yes, _____ no.

If YES depth of formation 10 feet
Why Health dept. requirement
Drillers Remarks: _____

CODED

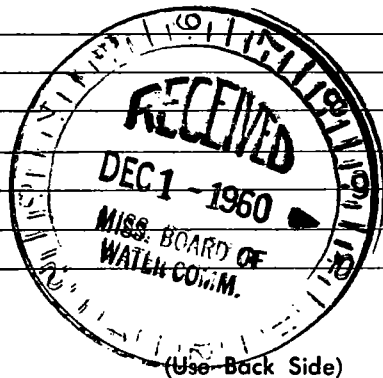

Well No.

