

**HARRISON**  
**K 28**  
**5-18-70**

MISSISSIPPI  
 BOARD OF WATER COMMISSIONERS  
 416 North State Street  
 Jackson, Mississippi 39201

**CODED**

WATER WELL DRILLERS LOG

May 18 1970 19 Mc Hill Well Works Harrison  
 date well completed firm name county well located

LANDOWNER: Robert Grosvenor  
Apt 1A Mountain Apt.  
Long Beach Miss.  
 (mailing address)

description of formations encountered	from	to
<u>clay</u>	<u>0</u>	<u>20</u>
<u>sand</u>	<u>20</u>	<u>40</u>
<u>Clay</u>	<u>40</u>	<u>180</u>
<u>sand</u>	<u>180</u>	<u>210</u>

WELL LOCATION:  
 sec 16 T 7 N R 12 E  
9 miles S N.W. of Long Beach  
 (distance) (direction) (nearest town)

WELL PURPOSE: Home  
 (home, irrigation, municipal, industrial)

- WELL COMPLETION DATA:
- (1) diameter (inches) 2"
  - (2) total depth (feet) 210'
  - (3) static water level (feet) 25' below above top of ground.
  - (4) casing gal. 200'  
 (material) (depth)  
70' if telescope see back.  
 (size)
  - (5) screen 10' (length) (depth to top)  
2" (size) SS. (material)
  - (6) pump 1 (HP) 8 (yield gpm)  
electric (type power)
  - (7) electric log no (yes or no)  
no (organization running log)
  - (8) how well bottom plugged sand  
shark

**CODED**


APR - 1 1971

DRILLERS REMARKS:

MISS. BD. OF  
 WATER COMM.

If well telescopes please sketch and show depths.

GROUND LEVEL

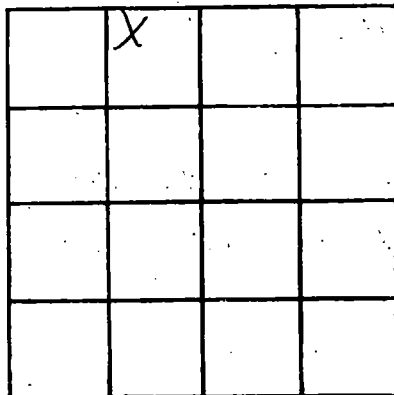

SECTION 16

Please indicate well location X.

ADDITIONAL INFORMATION

If more than one screen, show locations of each on sketch.