

K 31

10-23-61

WATER WELL DRILLERS LOG

**CODED**

K-315

Date: 10-23, 1961, Driller: Jetter Well Wks. County Harrison

(Name)

(1) Owner of Land: Bernard Cuevas  
(Name)

Rt. 1 Pass Christian, Miss.  
(Address)

(2) Location: NE 1/4, SE 1/4, Sec. 18 T3R12W

7 miles NE of PASS CHRISTIAN  
(distance) (direction) (Nearest Town)

(3) Topography: Hilly  
(Hilly) (Flat) (Level)

(4) Purpose of Well: domestic  
(Domestic Irrigation  
Municipal, Industrial, Other)

Description & Color of Materials  
Sand, Clay, Red Clay, Shell, etc.

Thick-  
ness  
Feet

Depth  
Feet

old well — 110

red sand 120 230

clay 125 355

sand ~~125~~ ~~355~~

27 382

Information upon completion of well:

(1) Diameter 2 inches.

(2) Total Depth 382 feet.

(3) Water Level 52 feet below top of ground.

(4) Cased ~~to~~ all, Size 2"

(5) Screen: Size 2", Length 5'

(6) Were any formations sealed against pollution?


no,  yes.

If YES depth of formation \_\_\_\_\_

Why \_\_\_\_\_

Drillers Remarks: \_\_\_\_\_

**CODED**

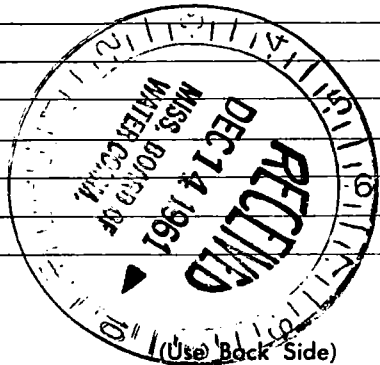

Well No.

0000

1971 00