

HAR. MISSISSIPPI BOARD OF WATER COMMISSIONERS

K 32

11-15-61

WATER WELL DRILLERS LOG

K-316
CODED

Date: 11-15, 1961, Driller: Sutter Well Works County Harrison

(Name)

(1) Owner of Land: Leonard Bell
(Name)

Rt. 1 Box 572 - Gulfport
(Address)

(2) Location: SW 1/4, NE 1/4, Sec. 33 T75R12W

3 miles NE of CUEVAS
(distance) (direction) (Nearest Town)

(3) Topography: Hilly
(Hilly) (Flat) (Level)

(4) Purpose of Well: domestic
(Domestic, Irrigation, Municipal, Industrial, Other)

Description & Color of Materials Sand, Clay, Red Clay, Shell, etc.	Thick- ness Feet	Depth Feet
<u>clay</u>	<u>10</u>	<u>10</u>
<u>sand</u>	<u>15</u>	<u>25</u>
<u>clay</u>	<u>365</u>	<u>390</u>
<u>sand</u>	<u>39</u>	<u>429</u>

Information upon completion of well:

(1) Diameter 2 inches.

(2) Total Depth 429 feet.

(3) Water level 2 feet below top of ground.

(4) Cased to all, Size 2"

(5) Screen: Size 2", Length 5'

(6) Were any formations sealed against pollution?


yes, no.

If YES depth of formation _____

Why _____

Drillers Remarks: _____

CODED

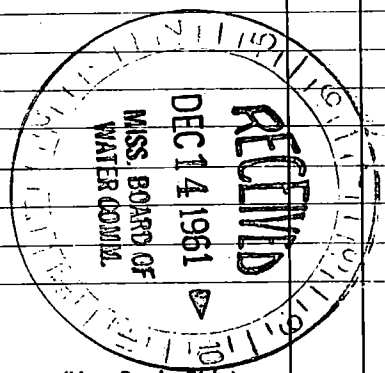

(Use Back Side)

Well No.

1944

[Faint, illegible text, possibly bleed-through from the reverse side of the page. The text is mostly illegible due to low contrast and blurring.]