

MISSISSIPPI BOARD OF WATER COMMISSIONERS

HAR.

K 34

12-22-62

WATER WELL DRILLERS LOG

could not find on top

Date: Jan 22, 1962

Driller: C. I. SWITZER WELL CO.

County Harrison

(Name)

(1) Owner of Land: First Bay Baptist Church
(Name)

Rt 2, Vandalia, Miss.
(Address)

(2) Location: 1/4, 1/4, Sec. T. R.

 miles of
(distance) (direction) (Nearest Town)

(3) Topography: X
(Hilly) (Flat) (Level)

(4) Purpose of Well: Domestic
(Domestic Irrigation
Municipal, Industrial, Other)

Description & Color of Materials
Sand, Clay, Red Clay, Shell, etc.

Thick-
ness
Feet

Depth
Feet

Clay	00	41
Sand, good	41	72
Clay	72	122
Sand, good	122	178

Information upon completion of well:

(1) Diameter 2" inches.

(2) Total Depth 178 feet.

(3) Water Level 26 feet below top of ground.

(4) Cased to 178', Size 2"


(5) Screen: Size 2", Length 10'

(6) Were any formations sealed against pollution?
X yes, no.

If YES depth of formation

Why Health Dept. Requirement

Drillers Remarks:

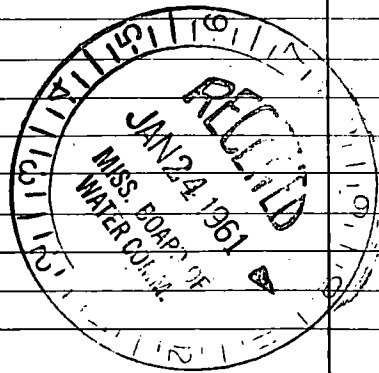

(Use Back Side)

Well No.

Retain this copy for your office files.

Handwritten text, possibly a name or title, located in the upper middle section of the page.

Handwritten text, possibly a date or a short phrase, located below the first line of text.

Handwritten text, possibly a signature or a name, located in the lower right section of the page.