

HAR.
K 36

WATER WELL DRILLERS LOG

B-300

Date: 2-5-62, 1962, Driller: H. A. Labadie **CODED** Harrison

(Name)

	Description & Color of Materials Sand, Clay, Red Clay, Shell, etc.	Thick- ness Feet	Depth Feet
(1) Owner of Land: <u>Al Graham</u> (Name)	<u>yellow clay</u>	<u>30</u>	<u>30</u>
<u>County Farm Road</u> (Address)	<u>white sand</u>	<u>10</u>	<u>40</u>
(2) Location: <u>1/4, 1/4, Sec. 4 T5R12W</u>	<u>yellow clay</u>	<u>20</u>	<u>60</u>
<u>7</u> miles <u>north</u> , of <u>Long Beach</u> . (distance) (direction) (Nearest Town)	<u>Blue clay</u>	<u>60</u>	<u>120</u>
	<u>Blue sand</u>	<u>30</u>	<u>150</u>
(3) Topography: <u>Hilly</u> (Hilly) (Flat) (Level)			
(4) Purpose of Well: <u>Domestic</u> (Domestic Irrigation Municipal, Industrial, Other)			


Information upon completion of well:

- (1) Diameter 2" inches.
- (2) Total Depth 150 feet.
- (3) Water Level 3.5 feet below top of ground.
- (4) Cased to 142, Size 2"
- (5) Screen: Size 80, Length 8
- (6) Were any formations sealed against pollution?
 yes, no.

If YES depth of formation _____
Why sand

Drillers Remarks: _____

CODED

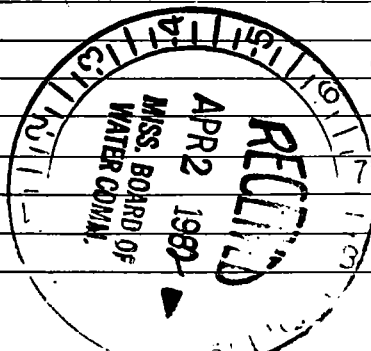

(Use Back Side)

Well No.

Retain this copy for your office files.

1880

1881

1882

1897