

HAR.

K 39

WATER WELL DRILLERS LOG

CODED

B

Date: April 10, 1962, Driller: H. A. Harrison

4-10-62

(Name)

(1) Owner of Land: Mrs. Francis Alexander
(Name)

County Farm Road
(Address)

(2) Location: 1/4, 1/4, Sec. 4 T5R12W

6 miles north of Long Beach
(distance) (direction) (Nearest Town)

(3) Topography: Hilly
(Hilly) (Flat) (Level)

(4) Purpose of Well: Domestic
(Domestic Irrigation
Municipal, Industrial, Other)

Description & Color of Materials
Sand, Clay, Red Clay, Shell, etc. Thickness Feet Depth Feet

Red clay	20	
Red sand	5	
Red clay	60	
Blue clay	210	
Blue sand	20	

CODED

Information upon completion of well:

(1) Diameter 1 1/4 inches.

(2) Total Depth 315 feet.

(3) Water Level 15 feet below top of ground.

(4) Cased to 305, Size 1 1/4

(5) Screen: Size 80, Length 10


(6) Were any formations sealed against pollution?

Yes, no.

If YES depth of formation 25 feet

Why sand

Drillers Remarks:

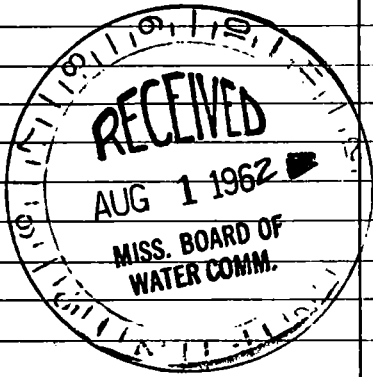

Retain this copy for your office files.

(Use Back Side)

Well No.

1892

1892

