

HAR.

K 40
7-3-62

WATER WELL DRILLERS LOG

CODED

Date: July 3, 1962, Driller: H. G. Ladnier County Harrison
(Name)

(1) Owner of Land: Mr McDaniel
(Name)
Canal Road
(Address)

(2) Location: 1/4, 1/4, Sec. 2 T75R12W
4 miles North of Gilgost
(distance) (direction) (Nearest Town)

(3) Topography: Hilly
(Hilly) (Flat) (Level)

(4) Purpose of Well: Domestic
(Domestic Irrigation
Municipal, Industrial, Other)

Description & Color of Materials Sand, Clay, Red Clay, Shell, etc.	Thick- ness Feet	Depth Feet
<u>yellow sand</u>	<u>12</u>	
<u>bottom sand</u>	<u>20</u>	
<u>Clay</u>	<u>106</u>	

Information upon completion of well:

(1) Diameter 2 inches.

(2) Total Depth 138 feet.

(3) Water Level 30 feet feet below top of ground.

(4) Cased to 128, Size 2 inch.


(5) Screen: Size 80, Length 10.

(6) Were any formations sealed against pollution?
 yes, no.

If YES depth of formation 50 feet.

Why Sand.

Drillers Remarks:

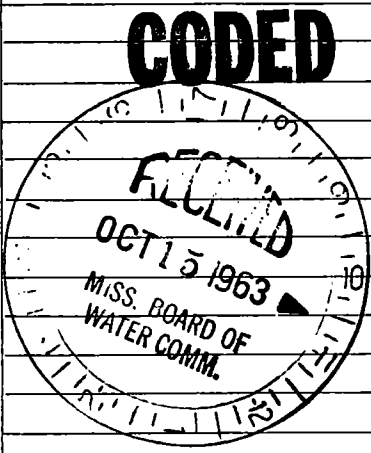

(Use Back Side)

Well No.

1111

Small...

598

Small...

Small...

