

K41
8-31-62

WATER WELL DRILLERS LOG

K
CODED

Date: 8-31, 1962, Driller: Sutter Well Works County Harrison
(Name)

(1) Owner of Land: E. R. Ramsey
(Name)
R 7D Gulfport, Miss.
(Address)

(2) Location: NW 1/4, SE 1/4, Sec. 34 T25R12, W
5 miles NW, of Long Beach
(distance) (direction) (Nearest Town)

(3) Topography: flat
(Hilly) (Flat) (Level)

(4) Purpose of Well: domestic
(Domestic Irrigation
Municipal, Industrial, Other)

Description & Color of Materials Sand, Clay, Red Clay, Shell, etc.	Thick-ness Feet	Depth Feet
<u>Surface sand</u>	<u>20</u>	<u>20</u>
<u>Clay</u>	<u>58</u>	<u>78</u>
<u>sand</u>	<u>12</u>	<u>90</u>
<u>Clay</u>	<u>108</u>	<u>198</u>
<u>sand</u>	<u>45</u>	<u>243</u>

CODED

Information upon completion of well:

(1) Diameter 2 inches.

(2) Total Depth 243 feet.

(3) Water Level 6 feet below top of ground.

(4) Cased to all, Size 2"


(5) Screen: Size 2", Length 5'

(6) Were any formations sealed against pollution?
no ✓

If YES depth of formation _____

Why _____

Drillers Remarks: _____

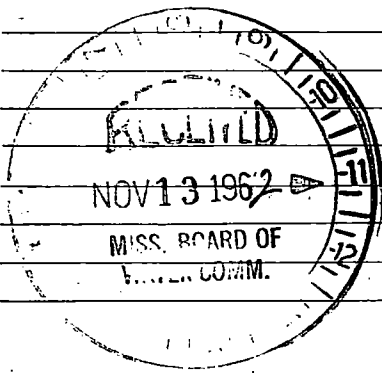

(Use Back Side)

Well No.

Handwritten text at the top of the page, possibly a title or header, which is mostly illegible due to blurring and noise.

100
100
Handwritten notes or a list of items, including what appears to be "J. ...".

Handwritten text in the upper right quadrant, possibly a name or a specific reference.

Handwritten text in the middle right section of the page.

Handwritten text in the lower right area, possibly a date or a number.

Handwritten text in the lower right area, possibly a date or a number.

