

K 42
9-26-62

WATER WELL DRILLERS LOG

CODED K

Date: Sept. 26, 1962 Driller: M & B Drilling Co County Harrison
(Name)

(1) Owner of Land: Mr. Cochran
(Name)

Tanner Rd, R.R. Long Beach Miss
(Address)

(2) Location: NE 1/4, SE 1/4, Sec 34 T24N R24W
2 miles N of Long Beach
(distance) (direction) (Nearest Town)

(3) Topography: Flat
(Hilly) (Flat) (Level)

(4) Purpose of Well: Domestic
(Domestic Irrigation
Municipal, Industrial, Other)

Description & Color of Materials Sand, Clay, Red Clay, Shell, etc.	Thick- ness Feet	Depth Feet
<u>Clay</u>	<u>22</u>	<u>22</u>
<u>Bl/Gr Clay</u>	<u>111</u>	<u>133</u>
<u>Fine Sand</u>	<u>8</u>	<u>141</u>
<u>Blue Clay</u>	<u>57</u>	<u>198</u>
<u>Coarse Sand</u>	<u>12</u>	<u>210</u>
<u>Blue Clay -</u>		

CODED

Information upon completion of well:

(1) Diameter 2 inches.

(2) Total Depth 210 feet.

(3) Water Level 2 feet below top of ground.

(4) Cased to 200, Size 2"


(5) Screen: Size 5/8x2", Length 10 FT.

(6) Were any formations sealed against pollution?
_____ yes, _____ no.

If YES depth of formation _____

Why _____

Drillers Remarks: _____

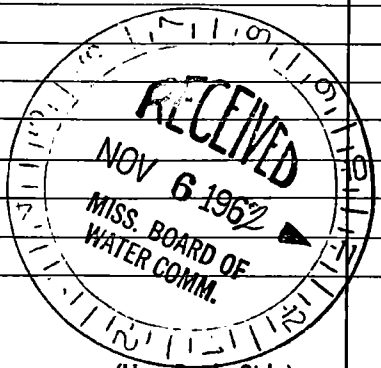

(Use Back Side)

Well No.

0000