

**CODED**

HAR.


K 44  
K-5-6363

WATER WELL DRILLERS LOG

Date: Jan 5, 1963, Driller: H. A. Ladner County Harrison  
(Name)

	Description & Color of Materials Sand, Clay, Red Clay, Shell, etc.	Thick- ness Feet	Depth Feet
(1) Owner of Land: <u>W. M. Baylorge</u> (Name)	<u>Red sand</u>	<u>20</u>	
<u>Dedeaux Road</u> (Address)	<u>Blue clay</u>	<u>248</u>	
(2) Location: <u>1/4, 1/4, Sec. 2 T25R12W</u>			
<u>5</u> miles <u>North</u> , of <u>Gulport</u> (distance) (direction) (Nearest Town)			
(3) Topography: <u>Hilly</u> (Hilly) (Flat) (Level)			
(4) Purpose of Well: <u>Domestic</u> (Domestic Irrigation Municipal, Industrial, Other)			

**CODED**

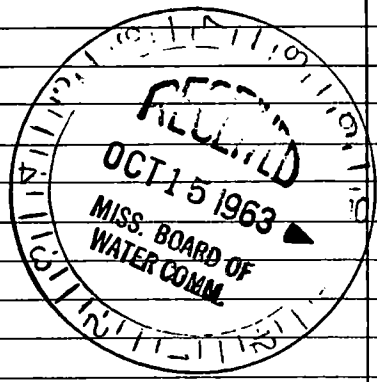

Information upon completion of well:

(1) Diameter 2 inches.

(2) Total Depth 328 feet.

(3) Water Level 25 feet below top of ground.

(4) Cased to 318, Size 2 inch

(5) Screen: Size 80, Length 10

(6) Were any formations sealed against pollution?  
✓ yes,        no.

If YES depth of formation 40 feet

Why sand

Drillers Remarks: \_\_\_\_\_

(Use Back Side)

Well No.

1000

