

HAR.

MISSISSIPPI BOARD OF WATER COMMISSIONERS

K45

2-9-63

WATER WELL DRILLERS LOG

CODED

Date: Feb 9, 1963, Driller: H. A. Ladner County Harrison  
(Name)

	Description & Color of Materials Sand, Clay, Red Clay, Shell, etc.	Thick- ness Feet	Depth Feet
(1) Owner of Land: Mrs N. L. New (Name) Orange Grove Road (Address)	yellow sand Clay Blue clay	<del>20</del> <del>80</del> 102	20 80 102
(2) Location: 1/4, 1/4, Sec. 2 T22R10W 6 miles north of Gulfport (distance) (direction) (Nearest town)			
(3) Topography: Hilly (Hilly) (Flat) (Level)			
(4) Purpose of Well: Domestic (Domestic Irrigation Municipal, Industrial, Other)			

CODED

Information upon completion of well:

(1) Diameter 2 inches.

(2) Total Depth 210 feet.

(3) Water Level 40 feet below top of ground.

(4) Cased to 200, Size 2 inch


(5) Screen: Size 80, Length 8 feet

(6) Were any formations sealed against pollution?  
 yes,  no.

If YES depth of formation 30

Why sand

Drillers Remarks:

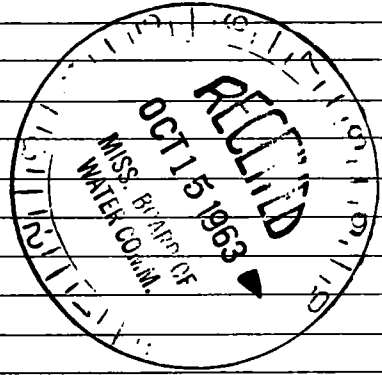

(Use Back Side)

Well No.

1910

4

Wm. C. ...  
...

...

...