

MISSISSIPPI BOARD OF WATER COMMISSIONERS

HAR.
K 48
7-3-63

WATER WELL DRILLERS LOG

CODED

Date: July 3, 1963, Driller: H. A. Ladnier County Harrison
(Name)

(1) Owner of Land: <u>H. R. Ross</u> (Name)	Description & Color of Materials Sand, Clay, Red Clay, Shell, etc.	Thick- ness Feet	Depth Feet
<u>Colman Road</u> (Address)	<u>yellow clay</u> <u>Blue clay</u>	<u>20</u> <u>16.5</u>	
(2) Location: <u>1/4, 1/4, Sec. 2 T25R12W</u> <u>6</u> miles <u>north</u> of <u>Gulfport</u> (distance) (direction) (Nearest town)	CODED		
(3) Topography: <u>Hilly</u> (Hilly) (Flat) (Level)			
(4) Purpose of Well: <u>Domestic</u> (Domestic Irrigation Municipal, Industrial, Other)			

Information upon completion of well:

(1) Diameter 2 inches.

(2) Total Depth 215 feet.

(3) Water level 10 feet below top of ground.

(4) Cased to 205, Size 2 inch.


(5) Screen: Size 2 inch Length 10.

(6) Were any formations sealed against pollution?
 yes, no.

If YES depth of formation 40


Why sand

Drillers Remarks: _____

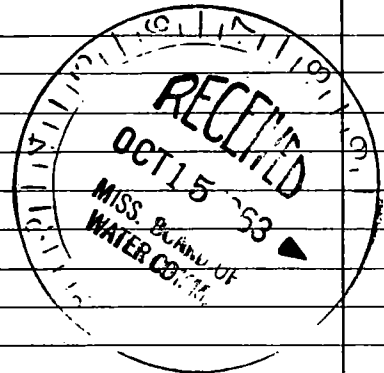

(Use Back Side)

Well No.

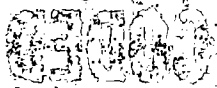

THE UNIVERSITY OF CHICAGO

PHYSICS DEPARTMENT

[The main body of the page contains extremely faint and illegible text, likely bleed-through from the reverse side of the paper. The text is scattered across the page and does not form any recognizable words or sentences.]