

HAR.  
K 49  
7-9-63

MISSISSIPPI BOARD OF WATER COMMISSIONERS

WATER WELL DRILLERS LOG

**CODED**

Date: July 9, 1963, Driller: H. A. Ladner County Harrison

(Name)

(1) Owner of Land: Vincent Court  
(Name)

John Clark Road  
(Address)

(2) Location: 1/4, 1/4, Sec. 2 T7SR12W

7 miles North of Long Beach  
(distance) (direction) (Nearest Town)

(3) Topography: Hilly  
(Hilly) (Flat) (Level)

(4) Purpose of Well: Domestic  
(Domestic Irrigation  
Municipal, Industrial, Other)

Description & Color of Materials  
Sand, Clay, Red Clay, Shell, etc.

Thick-  
ness  
Feet

Depth  
Feet

yellow clay 20  
Blue clay 15-2

**CODED**

Information upon completion of well:

(1) Diameter 2 inches.

(2) Total Depth 200 feet.

(3) Water Level 30 feet below top of ground.

(4) Cased to 192, Size 2 inch

(5) Screen: Size 2 inch Length 8


(6) Were any formations sealed against pollution?

✓ yes,        no.

If YES depth of formation 30

Why sand

Drillers Remarks:

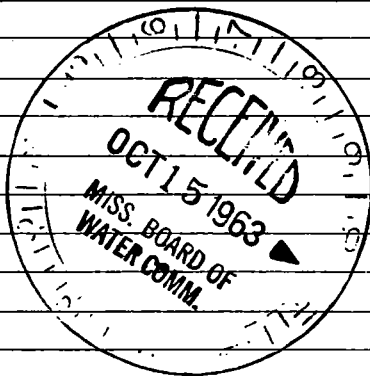

(Use Back Side)

Well No.

1944